II sketch

IREDELL COUNTY HEALTH DEPARTMENT

not on Computer

52075

STATESVILLE 704-878-5305 MOORESVILLE 704-664-5281

IMPROVEMENT PERMIT / CERTIFICATE OF COMPLETION / OPERATION PERMIT / EXISTING SYSTEM INSPECTION

PROPERTY DESCRIPTION NO. 18455 DATE 6-27-94 TAX MAP NO. 5 K-7-A-254 Watershed: ☐ Yes ☐ No

OWNER OR CONTRACTOR TT T PHONE: Business 878-6660 Home

ADDRESS PO Box 788 Sta

LOCATION 70E TR Morehead TR old well TL Big Forest 200' on nt

SUBDIVISION Forestacres BLOCK / SECTION II LOT 25bt LOT AREA 1.5 acres SITE CLASS. PS DESIGN FLOW 330 L.T.A.R. .25

Septic Tank: 1000 Gallons; STB 1017 Date 4-7-94

Pump Tank: Gallons; PT Date

Pump Make: Model Serial No.

Nitrification Field: No Fields Square Feet 960 Linear Feet 320

No Lines 5 Trench Width 36" Max Trench Bottom Depth 24" Gravel Depth 12"

☑ New System ☐ Repair System Type: I, II, III, IV, V, VI

System Description: Conv. Gravity

Repair System Description: Pump Panel

Maintenance Agreement Required: ☐ Yes ☑ No

☐ House/Mod. Home ☑ Mobile Home ☐ Business ☐ Other

No. Bedrooms 2 No. Bathrooms 2 No. Employees


☐ Slab ☑ Crawl Space ☐ Basement w/plumbing ☐ Basement wo/plumbing

Water Supply: ☐ Individual ☐ Community ☑ Public


Comments: This permit replaces Permit issued 6-2-94 alterations were necessary To accomodate MH Placement & kitchen That were installed

Comments:

INITIAL SITE SKETCH Too Deep.

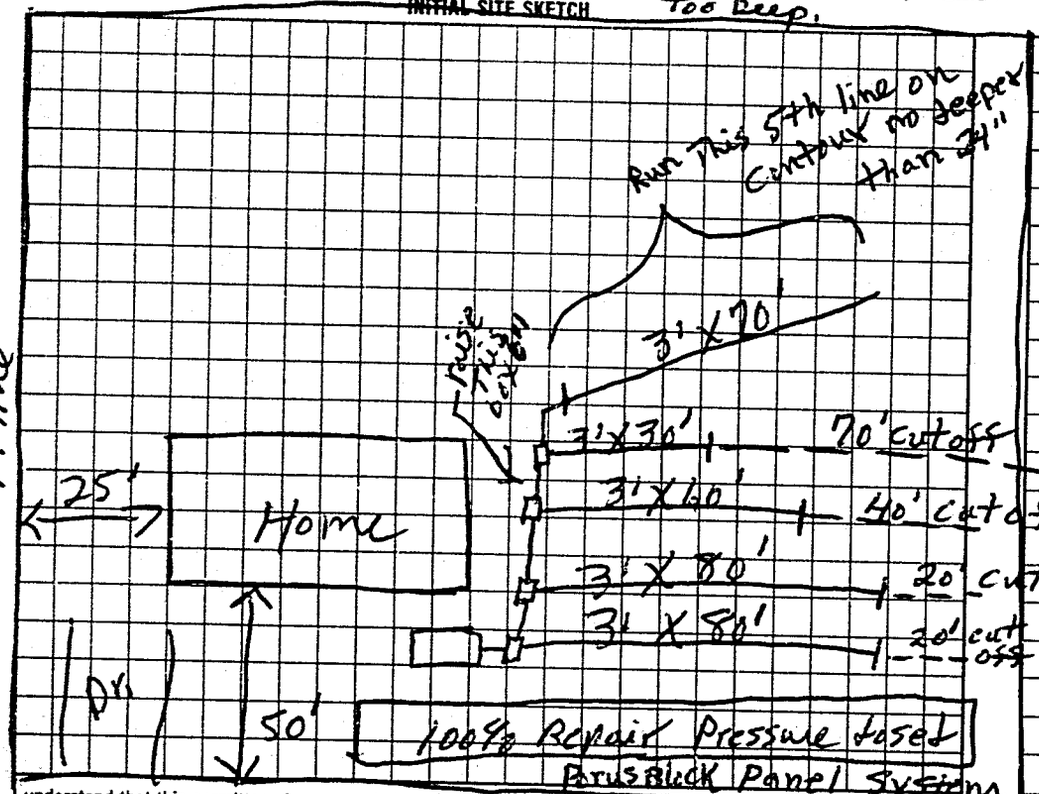

AS BUILT SKETCH

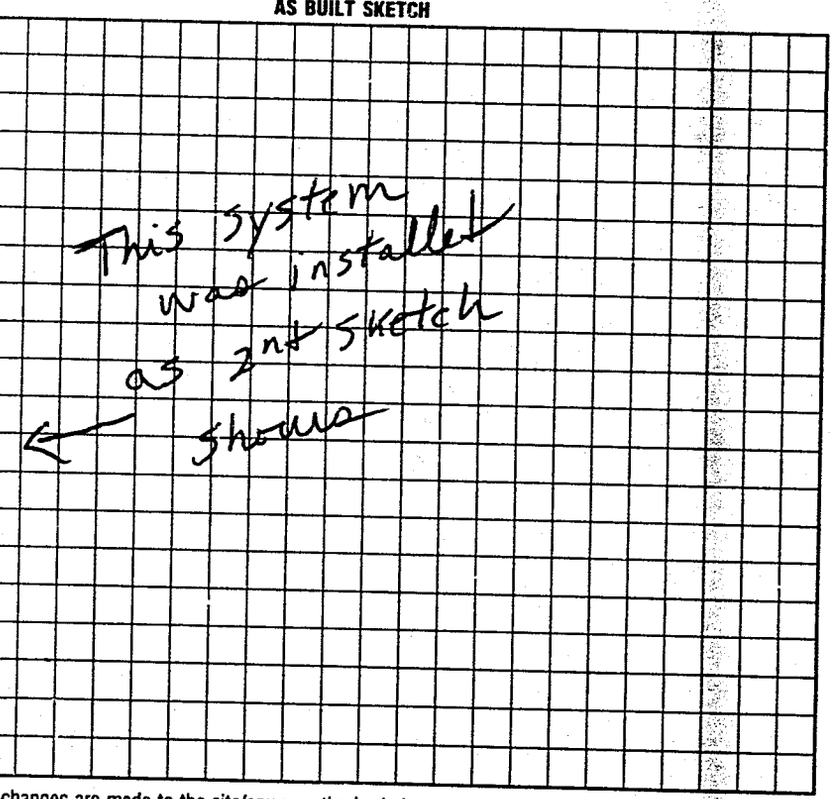

P. line

I understand that this permit can be suspended or revoked if any false information is supplied toward securing the permit/any unauthorized changes are made to the site/any unauthorized changes are made in the installation of the system. Improvement Permit is valid for 60 months from date of issuance.

Signed: x T T Strabet

Improvement Permit by: F. C. Moore date 7-5-94

Existing System Inspection by: date

Installed by: Donald Lackey

Certificate of Completion by: F. C. Moore date 7-5-94

Operation Permit by: date

HEALTH DEPT. COPY: WHITE INSPECTION COPY (FINAL): GREEN OWNER COPY (FINAL): YELLOW INSPECTION COPY (INITIAL): PINK OWNER COPY (INITIAL): GOLD

8 8 7 6 0 0