IREDELL COUNTY HEALTH DEPARTMENT

STATESVILLE 704-878-5305 MOORESVILLE 704-664-5281

IMPROVEMENT PERMIT / CERTIFICATE OF COMPLETION / OPERATION PERMIT / EXISTING SYSTEM INSPECTION

PROPERTY DESCRIPTION NO. 13364 DATE 4-[illegible]-94 TAX MAP NO. 5J-A-12

OWNER OR CONTRACTOR T+T Inc PHONE: Business Home Watershed: ☐ Yes ☑ No

ADDRESS Bethesda Rd

LOCATION NOE TR morehead TR ottwell Dr. TR Big Forest Drive 1/4mi on Lt.

SUBDIVISION Forest Acres BLOCK / SECTION IV LOT 175+176 LOT AREA 2 acres SITE CLASS. P3 DESIGN FLOW 360 L.T.A.R. .3

Septic Tank: 1000 Gallons: STB 358 Date 1-5-94

Pump Tank: 1000 Gallons; PT 1103 Date 8-25-93

Pump Make: Gould's Model 3888N Serial No. WB [illegible] 1HP 1PH

Nitrification Field: No Fields 1 Square Feet 1200 Linear Feet 400

No Lines 4 Trench Width 36" Max Trench Bottom Depth 24" Gravel Depth 12"

☑ New System ☐ Repair System Type: I, II, III, IV, V, VI

System Description: Pump To Conv. lines

Repair System Description: " " " "

Maintenance Agreement Required: ☐ Yes ☑ No

☐ House/Mod. Home ☑ Mobile Home ☐ Business ☐ Other

No. Bedrooms 3 No. Bathrooms 2 No. Employees

☐ Slab ☑ Crawl Space ☐ Basement w/plumbing ☐ Basement wo/plumbing

Water Supply: ☐ Individual ☐ Community ☑ Public

Comments:

Comments:

INITIAL SITE SKETCH


Location of the proposed attched Garage/carport addition does not appear to impact the existing on-site septic system.**NOTE:

Rusty Henderson REHS

Date: 8-2-12

ICHD-Environmental Health Division

AS BUILT SKETCH

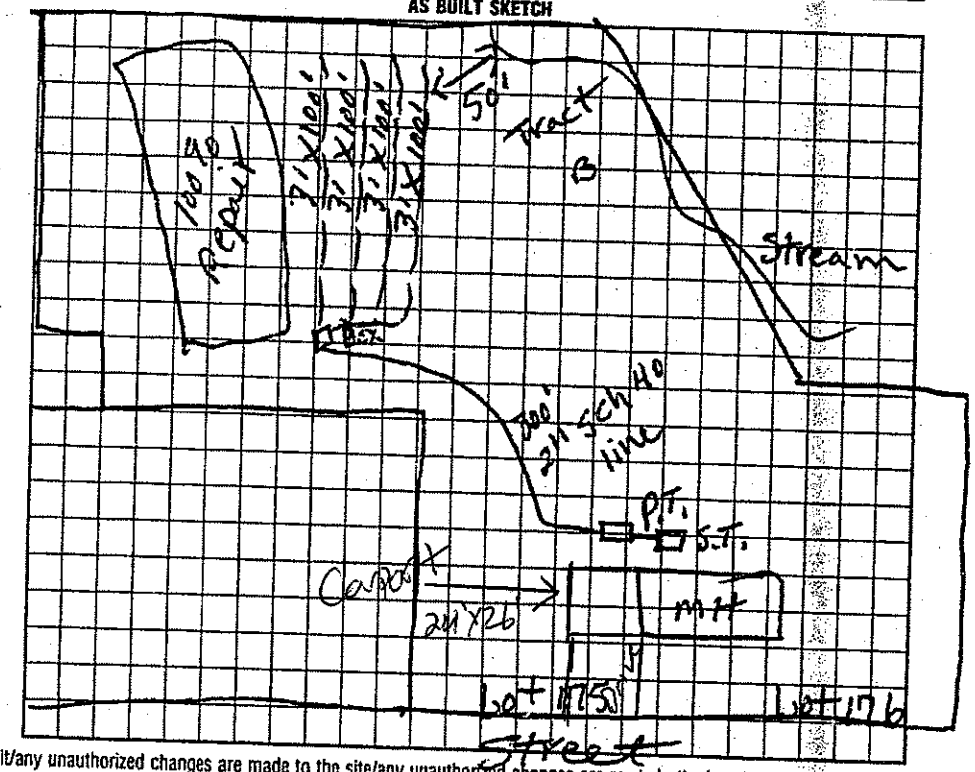

I understand that this permit can be suspended or revoked if any false information is supplied toward securing the permit/any unauthorized changes are made to the site/any unauthorized changes are made in the installation of the system. Improvement Permit is valid for 60 months from date of issuance.

Signed:

Improvement Permit by: date

Existing System Inspection by: date

Installed by: Donald Faubert

Certificate of Completion by: [redacted] date [redacted]

Operation Permit by: T. C. Moore date 4-19-94

HEALTH DEPT. COPY: WHITE INSPECTION COPY (FINAL): GREEN OWNER COPY (FINAL): YELLOW INSPECTION COPY (INITIAL): PINK OWNER COPY (INITIAL): GOLD