IREDELL COUNTY HEALTH DEPARTMENT

STATESVILLE 704-878-5305 MOORESVILLE 704-664-5281

IMPROVEMENT PERMIT / CERTIFICATE OF COMPLETION / OPERATION PERMIT / EXISTING SYSTEM INSPECTION

PROPERTY DESCRIPTION NO. 13423 DATE 1-21-94 TAX MAP NO 5K-9-A-173 Watershed: ☐ Yes ☒ No

OWNER OR CONTRACTOR ~~LT~~ T Inc. PHONE: Business 878 4666 Home

ADDRESS

LOCATION TOE TR Morehead TR Oldwell Rd TR Big Foot Yadkin Outlet

SUBDIVISION Forest Acres BLOCK / SECTION IV LOT 173 LOT AREA 110'X200' SITE CLASS. D3 DESIGN FLOW 240 L.T.A.R. .24

Septic Tank: 1000 Gallons; STB 356 Date 11-24-94
Pump Tank: Gallons; PT Date
Pump Make: Model Serial No.
Nitrification Field: No Fields 1 Square Feet 900 Linear Feet 300
No Lines 2 Trench Width 36 Max Trench Bottom Depth 24 Gravel Depth 12

☒ New System ☐ Repair System Type: I ☒ III, IV, V, VI
System Description: Conv Gravity
Repair System Description: " "
Maintenance Agreement Required: ☐ Yes ☐ No

☐ House/Mod. Home No. Bedrooms 2
☒ Mobile Home No. Bathrooms 2
☐ Business No. Employees
☐ Other

☐ Slab ☒ Crawl Space ☐ Basement w/plumbing ☐ Basement wo/plumbing


Water Supply:
☐ Individual
☐ Community
☒ Public

Comments:

Comments:

INITIAL SITE SKETCH

AS BUILT SKETCH

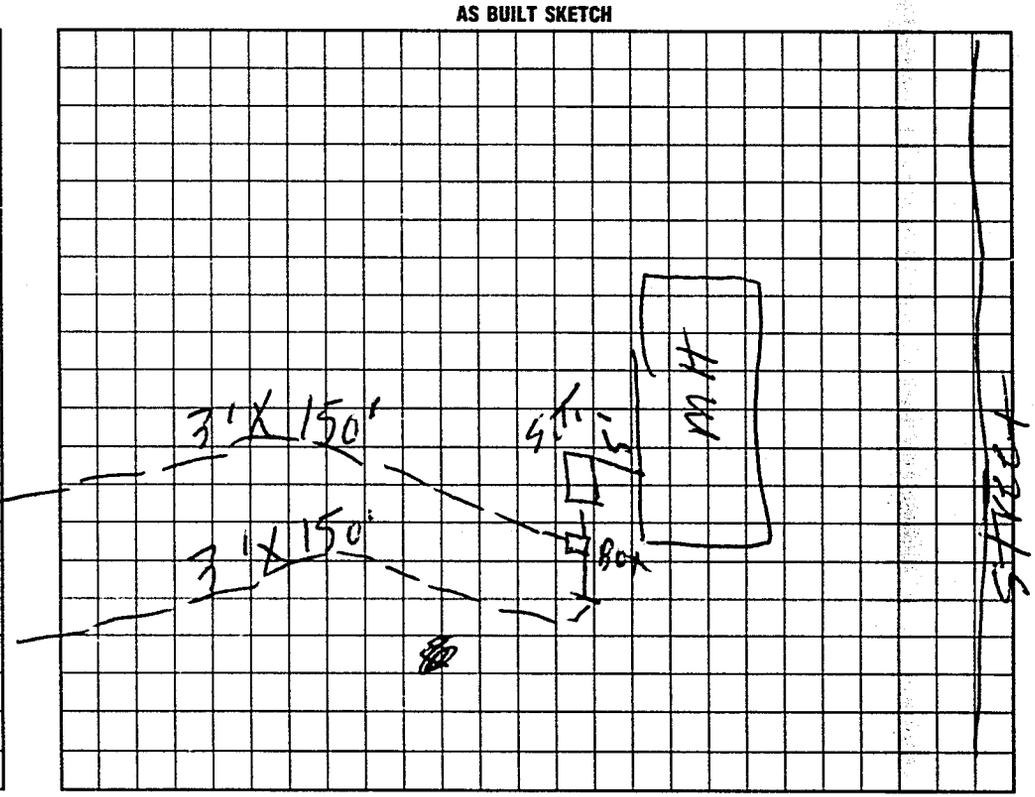

I understand that this permit can be suspended or revoked if any false information is supplied toward securing the permit/any unauthorized changes are made to the site/any unauthorized changes are made in the installation of the system. Improvement Permit is valid for 60 months from date of issuance.

Signed:

Improvement Permit by: R. C. Moore date 10-31-91

Existing System Inspection by: date

Installed by: Donald Jackson

Certificate of Completion by: R. C. Moore date 1-21-94

Operation Permit by: date

HEALTH DEPT. COPY: WHITE INSPECTION COPY (FINAL): GREEN OWNER COPY (FINAL): YELLOW INSPECTION COPY (INITIAL): PINK OWNER COPY (INITIAL): GOLD