~~230~~ 11:30

IREDELL COUNTY HEALTH DEPARTMENT

STATESVILLE 704-878-5305 MOORESVILLE 704-664-5281

IMPROVEMENT PERMIT / AUTHORIZATION TO CONSTRUCT / OPERATION PERMIT / EXISTING SYSTEM INSPECTION

PERMIT# 75242 PIN# 4763 63 8085 DATE 7-31-98

OWNER OR CONTRACTOR Tsumas Family LTD. PHONE: Business 878-6660 Home

ADDRESS 849 Bell Farm Rd / Statesville N.C.

LOCATION US 70 E TR morehead Rt TR Oil well House Rt TR Big Forest on left.

SUBDIVISION Forest Acres BLOCK / SECTION 4 LOT 8 LOT AREA .143 acres SITE CLASS PS DESIGN FLOW 360 L.T.A.R. .3

Septic Tank: 1000 Gallons; STB 826 Date 4/9/99 ☑ New System ☐ Repair System Type: I II III IV V VI

Pump Tank: ____ Gallons; PT ____ Date ____ System Description: Conv. Gravity

Pump Make: ____ Model ____ Serial No. ____ Repair System Description Pump To 2nd Rock

Nitrification Field: No Fields 1 Square Feet 1200 Linear Feet 400 Maintenance Agreement Required: ☐ Yes ☐ No

No Lines 5 @ Trench Width 36" Max Trench Bottom Depth 36" Gravel Depth 12" ☐ Slab ☐ Crawl Space ☐ Basement w/plumbing ☐ Basement wo/plumbing


☐ House/Mod. Home No. Bedrooms 3
☑ Mobile Home No. Bathrooms 2
☐ Business No. Employees ____
☐ Other ____

Water Supply: ☐ Individual ☑ Public ☐ Community


Comments:/Conditions:

Comments:/Conditions:

INITIAL SITE SKETCH

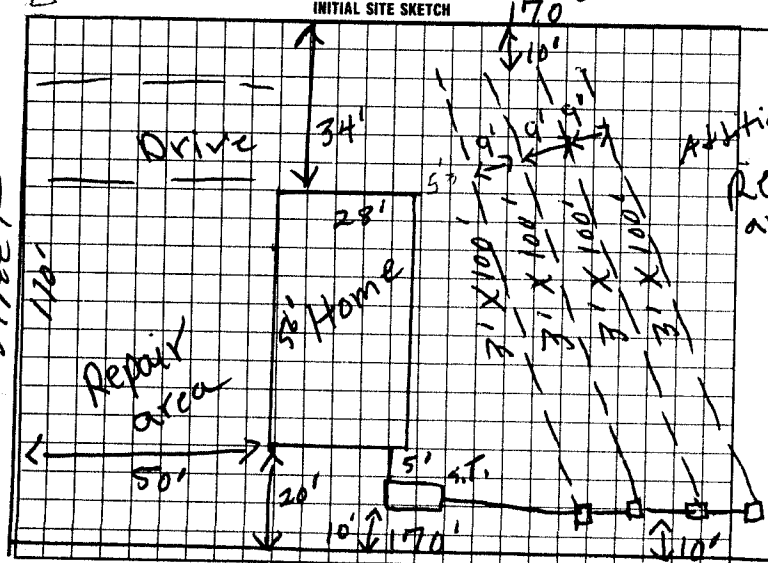

AS BUILT SKETCH

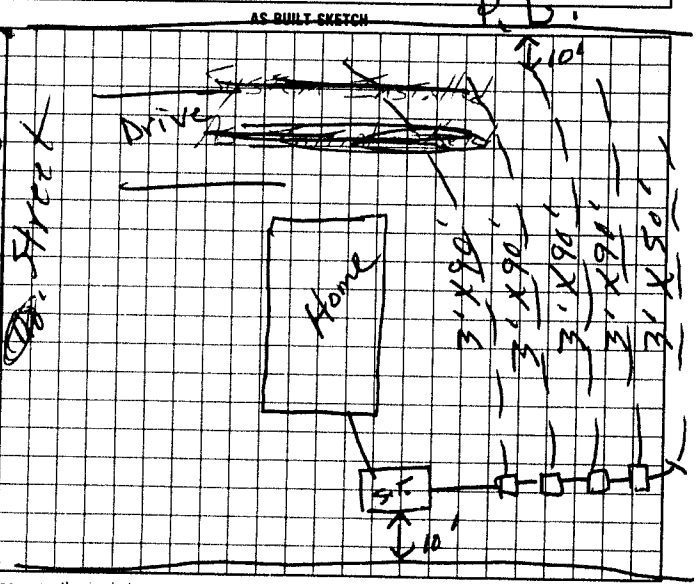

I understand that this permit can be suspended or revoked if any false information is supplied toward securing the permit/any unauthorized changes are made to the site/any unauthorized changes are made in the installation of the system. Improvement Permit with plat valid without expiration. Improvement Permit with site plan valid for sixty months. Authorization to Construct is valid for a period equal to that of Improvement Permit – not to exceed sixty months.

Signed: _____ date 10/23/98 Installed by: Donald Locke

Improvement Permit by: P.C. Moore date 7-31-98 Operation Permit by: P.C. Moore date 2-11-99

Authorization to Construct by: P.C. Moore date 7-31-98 Existing System Inspection by: _____ date _____

HEALTH DEPT. COPY: WHITE INSPECTION COPY (FINAL): GREEN OWNER COPY (FINAL): YELLOW INSPECTION COPY (INITIAL): PINK OWNER COPY (INITIAL): GOLD