IREDELL COUNTY HEALTH DEPARTMENT

STATESVILLE 704-878-5305 MOORESVILLE 704-664-5281

IMPROVEMENT PERMIT / CERTIFICATE OF COMPLETION / OPERATION PERMIT / EXISTING SYSTEM INSPECTION

PROPERTY DESCRIPTION NO. 26016 DATE 2-28-97 TAX MAP NO. Pin. 4763-57-3335 Watershed: ☐ Yes ☑ No

OWNER OR CONTRACTOR T+T Co Inc. PHONE: Business 878-6660 Home

ADDRESS 849 Bell Fm Rd

LOCATION 64E TR Bell Fm Rd TL oakcreek TR Buckwheat 6th lot left.

SUBDIVISION Oakcreek BLOCK / SECTION LOT 344 LOT AREA .45±5 SITE CLASS. P5 DESIGN FLOW 360 L.T.A.R. 1.3

Septic Tank: 1000 Gallons; STB 1012 Date 2-4-98

Pump Tank: Gallons; PT Date

Pump Make: Model Serial No.

Nitrification Field: No Fields 1 Square Feet 1200 Linear Feet 400

No Lines 4 Trench Width 36" Max Trench Bottom Depth 36" Gravel Depth 12"

☑ New System ☐ Repair System Type: I II III IV V VI

System Description: Conv. Gravity

Repair System Description: Chambers

Maintenance Agreement Required: ☐ Yes ☑ No

☐ House/Mod. Home ☑ Mobile Home ☐ Business ☐ Other

No. Bedrooms 3 No. Bathrooms 2 No. Employees


☐ Slab ☑ Crawl Space ☐ Basement w/plumbing ☐ Basement wo/plumbing

Water Supply: ☐ Individual ☐ Community ☑ Public


Comments:

Comments:

INITIAL SITE SKETCH

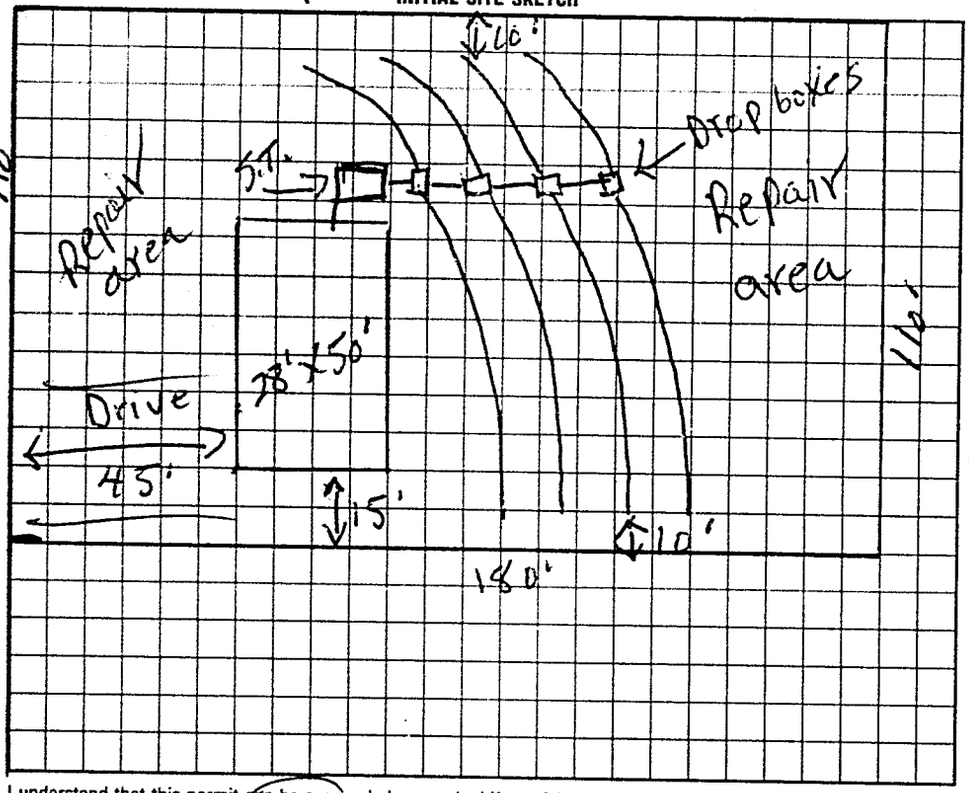

AS BUILT SKETCH

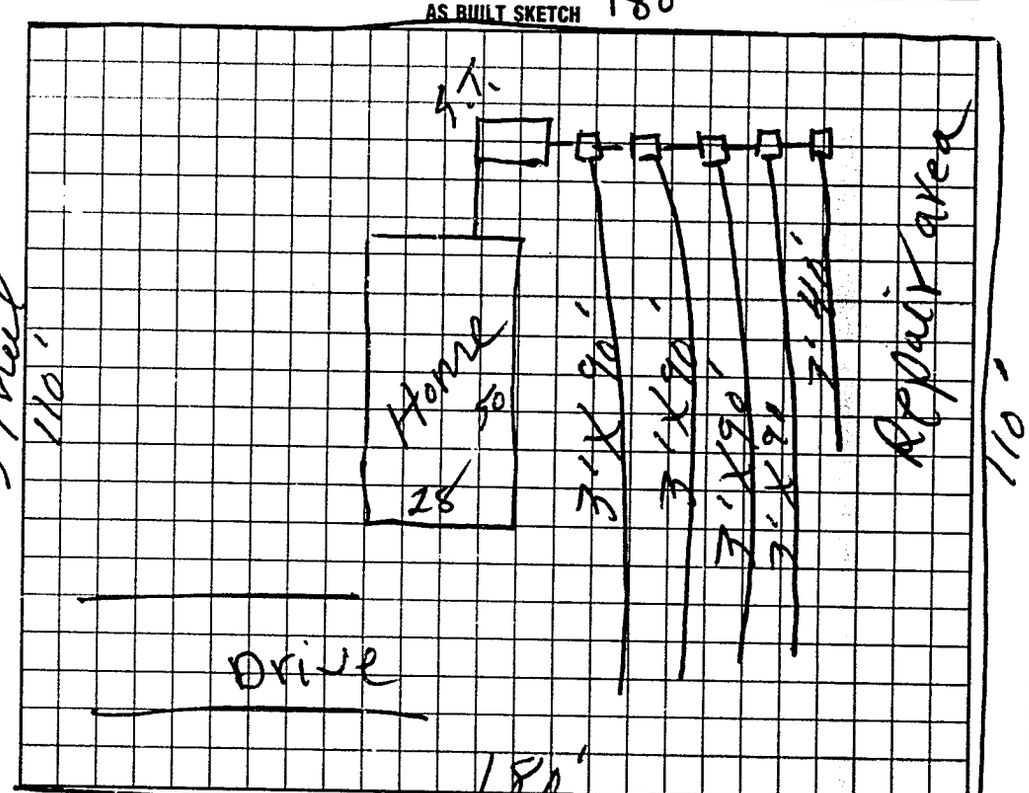

I understand that this permit can be suspended or revoked if any false information is supplied toward securing the permit/any unauthorized changes are made to the site/any unauthorized changes are made in the installation of the system. Improvement Permit is valid for 60 months from date of issuance.

Signed:

Improvement Permit by: L. C. Moore date 2-28-97

Authorization to Cover Existing System Inspection by: L. C. moore date 2-28-97

Installed by: Donald Fachs

Certificate of Completion by: date

Operation Permit by: L. C. moore date 4-7-98

HEALTH DEPT. COPY: WHITE INSPECTION COPY (FINAL): GREEN OWNER COPY (FINAL): YELLOW INSPECTION COPY (INITIAL): PINK OWNER COPY (INITIAL): GOLD

to cover Authorization to Cover. Expires 6 months from issue