IREDELL COUNTY HEALTH DEPARTMENT

STATESVILLE 704-878-5305 MOORESVILLE 704-664-5281

IMPROVEMENT PERMIT / CERTIFICATE OF COMPLETION / OPERATION PERMIT / EXISTING SYSTEM INSPECTION

PROPERTY DESCRIPTION NO. 26015 8221 DATE 2-28-97 TAX MAP NO. Pin 4763-52-3335 Watershed: ☐ Yes ☐ No

OWNER OR CONTRACTOR T+T Co Inc. PHONE: Business 8786660 Home

ADDRESS 849 Bell Fm Rd Statesville

LOCATION 64E TR Bell Fm Rd Turn oakcreek TR Buckwheat 5th lot left.

SUBDIVISION Oakcreek BLOCK / SECTION LOT 3#3 LOT AREA 1.4545 Acres SITE CLASS. P5 DESIGN FLOW 360 L.T.A.R. 15

Septic Tank: 1000 Gallons; STB 1012 Date 9-23-96
Pump Tank: Gallons; PT Date
Pump Make: Model Serial No.
Nitrification Field: No Fields 1 Square Feet 1200 Linear Feet 400
No Lines 4 Trench Width 36" Max Trench Bottom Depth 36" Gravel Depth 12"

☐ New System ☐ Repair System Type: ☒ II ☐ III, IV, V, VI
System Description: Conv. Gravity
Repair System Description: Gravity Chambers
Maintenance Agreement Required: ☐ Yes ☒ No

☐ House/Mod. Home ☒ Mobile Home ☐ Business ☐ Other
No. Bedrooms 3 No. Bathrooms 2 No. Employees


☐ Slab ☒ Crawl Space ☐ Basement w/plumbing ☐ Basement wo/plumbing

Water Supply: ☐ Individual ☐ Community ☒ Public

Comments:

Comments:

INITIAL SITE SKETCH

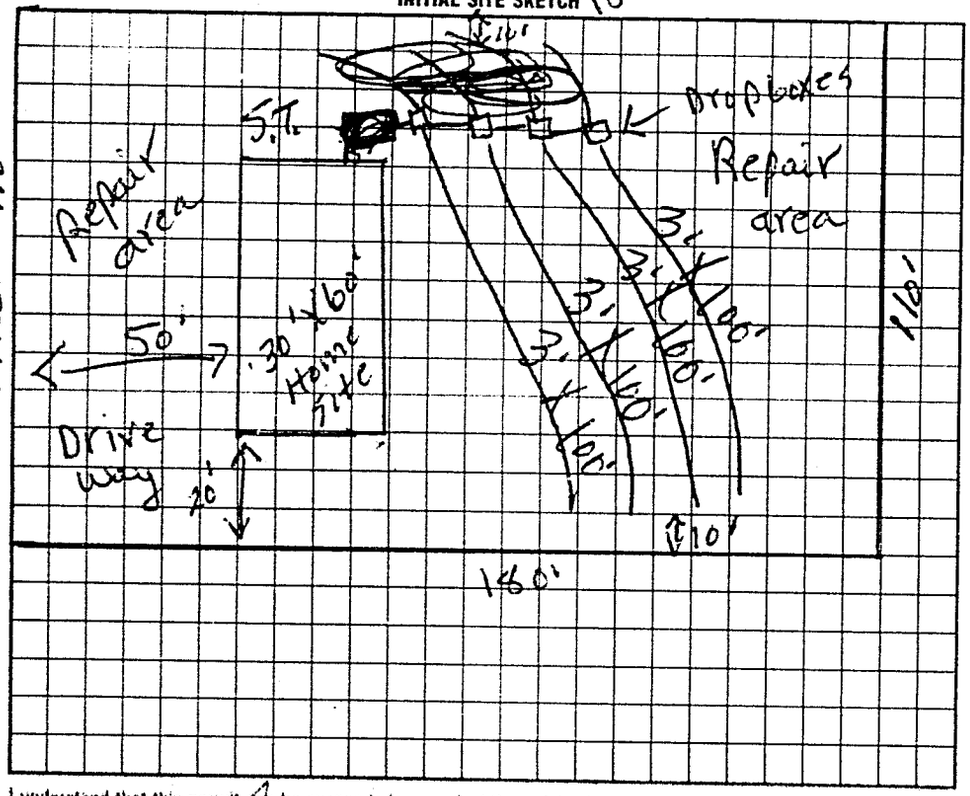

AS BUILT SKETCH

Same as initial Sketch

I understand that this permit can be suspended or revoked if any false information is supplied toward securing the permit/any unauthorized changes are made to the site/any unauthorized changes are made in the installation of the system. Improvement Permit is valid for 60 months from date of issuance.

Signed:

Improvement Permit by: L. C. Moore date 2-28-97

Existing System Inspection by: L. C. Moore date 2-28-97

Installed by: Donald Farley

Certificate of Completion by: date

Operation Permit by L. C. Moore date 11-25-98

to court

Authorization to court Expires 60 mos from issue

HEALTH DEPT COPY-WHITE INSPECTION COPY (FINAL) GREEN OWNER COPY (FINAL) YELLOW INSPECTION COPY (INITIAL) PINK OWNER COPY (INITIAL) GOLD

61500