IREDELL COUNTY HEALTH DEPARTMENT

STATESVILLE 704-878-5305 MOORESVILLE 704-664-5281

IMPROVEMENT PERMIT / CERTIFICATE OF COMPLETION / OPERATION PERMIT / EXISTING SYSTEM INSPECTION

PROPERTY DESCRIPTION NO. 26039 DATE 5-7-97 TAX MAP NO. 4763573375 Watershed: ☐ Yes ☒ No

OWNER OR CONTRACTOR T+T INC. PHONE: Business 878-6660 Home

ADDRESS 849 Bell Farm Rd

LOCATION Bell Farm Rd TL oakcreek TR Teak DR 6th lot Rt

SUBDIVISION Oakcreek BLOCK / SECTION LOT 390 LOT AREA .4545 SITE CLASS PS DESIGN FLOW 360 L.T.A.R. .24

Septic Tank: 1000 Gallons; STB 1012 Date 6-13-97

Pump Tank: Gallons; PT Date

Pump Make: Model Serial No.

Nitrification Field: No Fields 1 Square Feet 960 Linear Feet 320

No Lines 5 Trench Width 36" Max Trench Bottom Depth 36" Gravel Depth N/A

☒ New System ☐ Repair System Type: I, II, III, IV, V, VI

System Description: Gravity Chamber

Repair System Description: Pump to Chambers

Maintenance Agreement Required: ☐ Yes ☐ No

☐ House/Mod. Home No. Bedrooms 3

☒ Mobile Home No. Bathrooms 2

☐ Business No. Employees

☐ Other


☐ Slab ☒ Crawl Space ☐ Basement w/plumbing ☐ Basement wo/plumbing

Water Supply: ☐ Individual ☐ Community ☒ Public

Comments:

Comments:

INITIAL SITE SKETCH

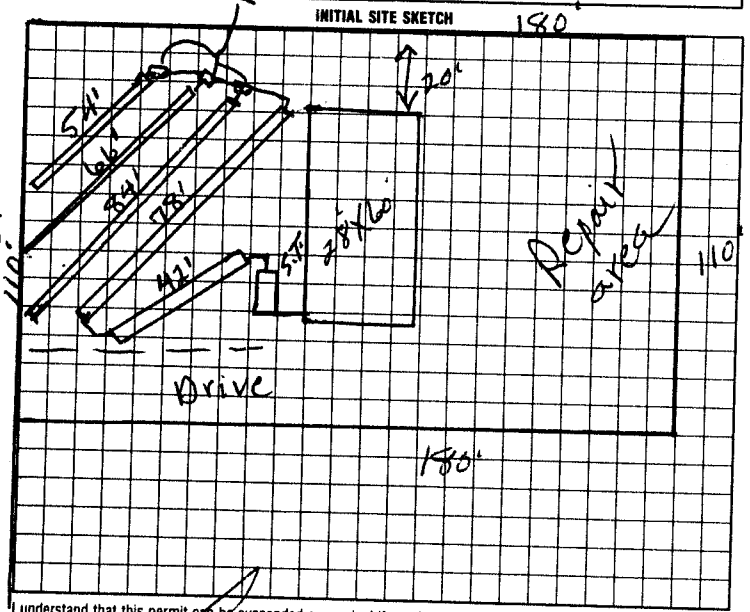

AS BUILT SKETCH

Same as initial sketch

I understand that this permit can be suspended or revoked if any false information is supplied toward securing the permit/any unauthorized changes are made to the site/any unauthorized changes are made in the installation of the system. Improvement Permit is valid for 60 months from date of issuance.

Signed:

Improvement Permit by: P.C. Moore date 5-7-97

Existing System Inspection by: Authorization to count P.C. Moore date 5-7-97

Installed by: Donald Farley

Certificate of Completion by: date

Operation Permit by: P.C. Moore date 8-31-99

HEALTH DEPT. COPY: WHITE INSPECTION COPY (FINAL): GREEN OWNER COPY (FINAL): YELLOW INSPECTION COPY (INITIAL): PINK OWNER COPY (INITIAL): GOLD

Authorization to count EXPIRES 60 MOS FROM ISSUE