IREDELL COUNTY HEALTH DEPARTMENT

STATESVILLE 704-878-5305 MOORESVILLE 704-664-5281

IMPROVEMENT PERMIT / CERTIFICATE OF COMPLETION / OPERATION PERMIT / EXISTING SYSTEM INSPECTION

PROPERTY DESCRIPTION NO. 26014 DATE 2-28-97 TAX MAP NO. PIN 4763-57-3335 Watershed: ☐ Yes ☒ No

OWNER OR CONTRACTOR T&T Co. Inc. PHONE: Business 878-6660 Home

ADDRESS 349 Bell Farm Rd Statesville

LOCATION 64E TR Bell Rd Turn oakcreek TR Buckwheat 4th lot left

SUBDIVISION Oakcreek BLOCK / SECTION LOT 342 LOT AREA .4545 acr. SITE CLASS. PS DESIGN FLOW 360 L.T.A.R. .3

Septic Tank: 1000 Gallons; STB 1012 Date 5-18-97

Pump Tank: Gallons; PT Date

Pump Make: Model Serial No.

Nitrification Field: No Fields 1 Square Feet 1200 Linear Feet 400

No Lines 4 Trench Width 36" Max Trench Bottom Depth 36" Gravel Depth 12"

☐ New System ☐ Repair System Type: I II III, IV, V, VI

System Description: Conv. Gravity

Repair System Description: Gravity Chambers

Maintenance Agreement Required: ☐ Yes ☐ No

☐ House/Mod. Home ☐ Mobile Home ☐ Business ☐ Other

No. Bedrooms 3 No. Bathrooms 2 No. Employees


☐ Slab ☐ Crawl Space ☐ Basement w/plumbing ☐ Basement wo/plumbing

Water Supply: ☐ Individual ☐ Community ☒ Public


Comments:

Comments: + Pump To Chambers In Front Yard for Repair area

INITIAL SITE SKETCH 180'

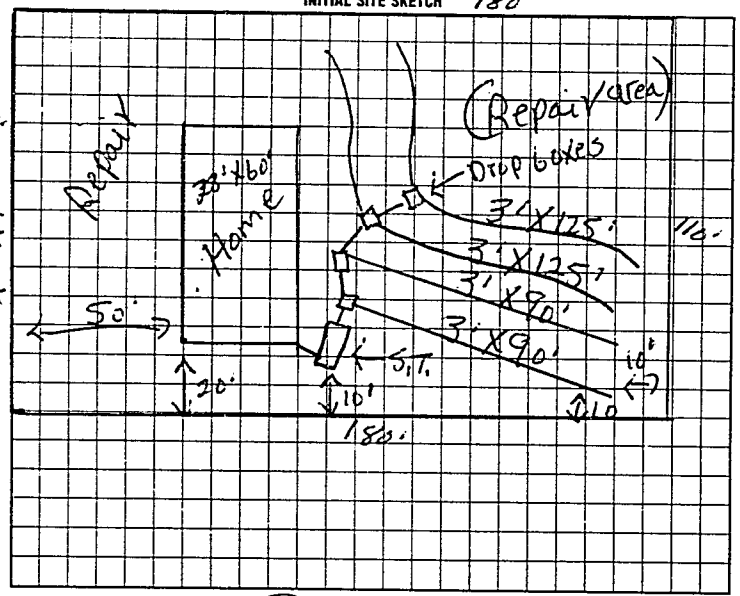

AS BUILT SKETCH

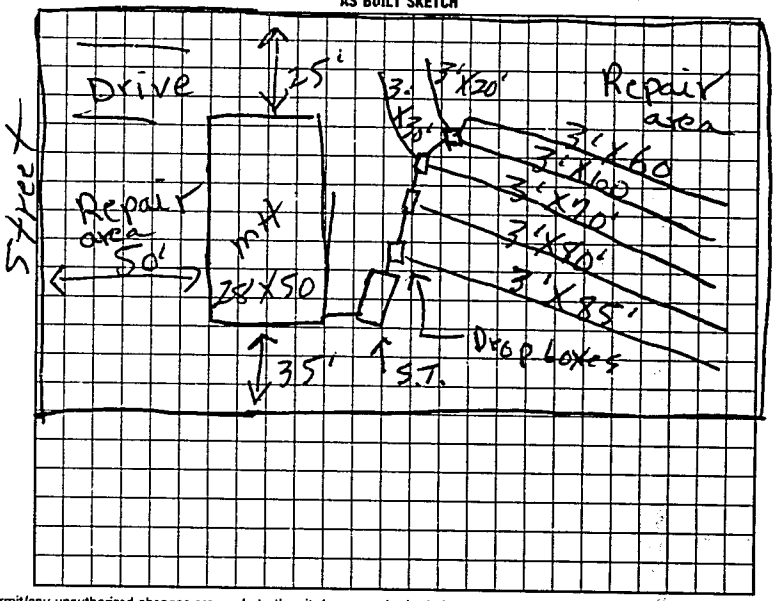

I understand that this permit can be suspended or revoked if any false information is supplied toward securing the permit/any unauthorized changes are made to the site/any unauthorized changes are made in the installation of the system. Improvement Permit is valid for 60 months from date of issuance.

Signed:

Improvement Permit by: P.C. Moore date 2-28-97

Authorization to Construct

Existing System Inspection by: P.C. Moore date 2-28-97

Installed by: Donald Lackey

Certificate of Completion by: date

Operation Permit by: P.C. Moore date 7-25-97

HEALTH DEPT COPY WHITE INSPECTION COPY (FINAL) GREEN OWNER COPY (FINAL) YELLOW INSPECTION COPY (INITIAL) PINK OWNER COPY (INITIAL) GOLD

to Const.

Authorization to Const. Expires 60 mos from issue

6 1 6 2 0 0