#9125 9-2657

IREDELL COUNTY HEALTH DEPARTMENT

STATESVILLE 704-878-5305 MOORESVILLE 704-664-5281

IMPROVEMENT PERMIT / CERTIFICATE OF COMPLETION / OPERATION PERMIT / EXISTING SYSTEM INSPECTION

PROPERTY DESCRIPTION NO. 26038 DATE 5-6-97 TAX MAP NO. 4763573335 Watershed: ☐ Yes ☐ No

OWNER OR CONTRACTOR T+T PHONE: Business 878 6660 Home

ADDRESS 849 Bell Rd

LOCATION Bell Rd Turn oakcreek TR Teak Drive 5th lot Rt

SUBDIVISION Oakcreek BLOCK / SECTION LOT 389 LOT AREA .4545 SITE CLASS PS DESIGN FLOW 360 L.T.A.R. .28

Septic Tank: 1000 Gallons; STB 160 Date 2-2-97
Pump Tank: Gallons; PT Date
Pump Make: Model Serial No.
Nitrification Field: No Fields 1 Square Feet 960 Linear Feet 320
No Lines 4 Trench Width 36" Max Trench Bottom Depth 36" Gravel Depth N/A

☑ New System ☐ Repair System Type: I II III IV, V, VI
System Description: Gravity chambers
Repair System Description: Pump To chambers
Maintenance Agreement Required: ☐ Yes ☑ No

☐ House/Mod. Home ☐ Mobile Home ☐ Business ☐ Other
No. Bedrooms 3 No. Bathrooms 2 No. Employees
☐ Slab ☑ Crawl Space ☐ Basement w/plumbing ☐ Basement wo/plumbing


Water Supply: ☐ Individual ☐ Community ☑ Public

Comments:
Keep System 10' From Property line. Remove all Terrace In front


Comments:

Yard before installation

INITIAL SITE SKETCH 190

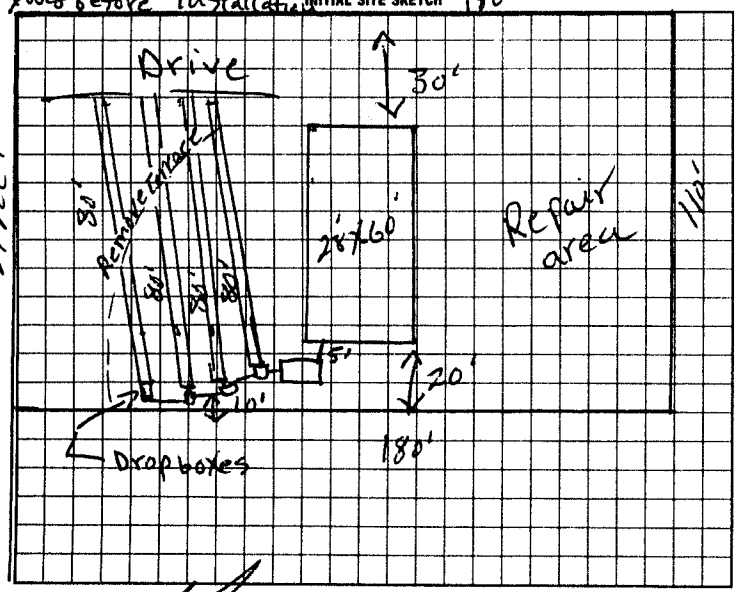

AS BUILT SKETCH

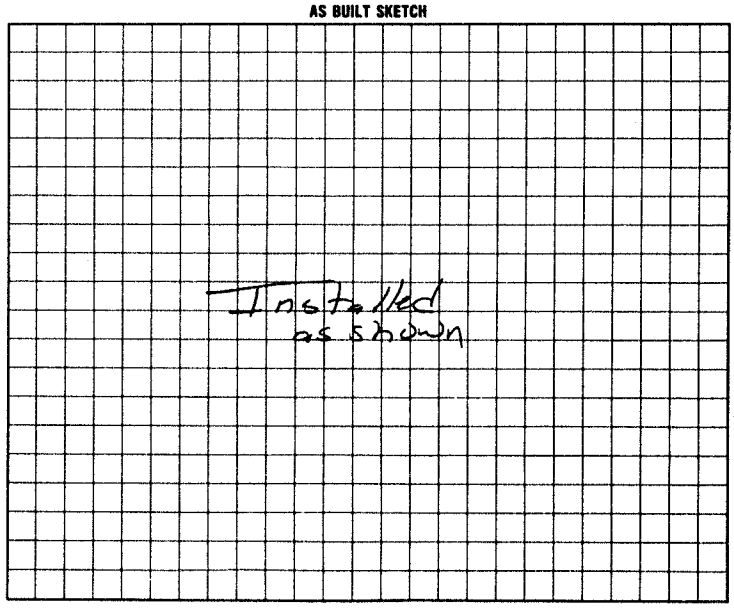

Street ← 110'

I understand that this permit can be suspended or revoked if any false information is supplied toward securing the permit/any unauthorized changes are made to the site/any unauthorized changes are made in the installation of the system. Improvement Permit is valid for 60 months from date of issuance.

Signed:

Improvement Permit by: authorization to cover R.C. Moore date 5-6-97

Existing System Inspection by: R.C. Moore date 5-6-97

Installed by: T+T Betty Sigmon

Certificate of Completion by: date

Operation Permit by: Mark Cook RS date 3-31-97

authorization to cover expires 60 mos from issue

HEALTH DEPT. COPY: WHITE INSPECTION COPY (FINAL): GREEN OWNER COPY (FINAL): YELLOW INSPECTION COPY (INITIAL): PINK OWNER COPY (INITIAL): GOLD