78230

IREDELL COUNTY HEALTH DEPARTMENT

STATESVILLE 704-878-5305 MOORESVILLE 704-664-5281

IMPROVEMENT PERMIT / CERTIFICATE OF COMPLETION / OPERATION PERMIT / EXISTING SYSTEM INSPECTION

PROPERTY DESCRIPTION NO. 26013 DATE 3-3-97 TAX MAP NO. 4763-57-3375 Watershed: ☐ Yes ☐ No

OWNER OR CONTRACTOR T+T Co Inc. PHONE: Business 878 6660 Home

ADDRESS 849 Bell Fm Rd

LOCATION 64E to Bell Fm Rd TL oakcreek Rd TR Buckwheat 3rd lot left

SUBDIVISION Oakcreek BLOCK / SECTION LOT 341 LOT AREA .4546 SITE CLASS. PS DESIGN FLOW 360 L.T.A.R. .3

Septic Tank: 1000 Gallons; STB 1012 Date 8-24-98 ☑ New System ☐ Repair System Type: I, II, III, IV, V, VI

Pump Tank: Gallons; PT Date System Description: Conv. Gravity

Pump Make: Model Serial No. Repair System Description: Chambers

Nitrification Field: No Fields 1 Square Feet 1200 Linear Feet 400 Maintenance Agreement Required: ☐ Yes ☐ No

No Lines 4 5 Trench Width 36" Max Trench Bottom Depth 36" Gravel Depth 12"

☐ House/Mod. Home ☑ Mobile Home ☐ Business ☐ Other

No. Bedrooms 3 No. Bathrooms 2 No. Employees


☐ Slab ☑ Crawl Space ☐ Basement w/plumbing ☐ Basement wo/plumbing

Water Supply: ☐ Individual ☐ Community ☑ Public


Comments:

Comments:

INITIAL SITE SKETCH

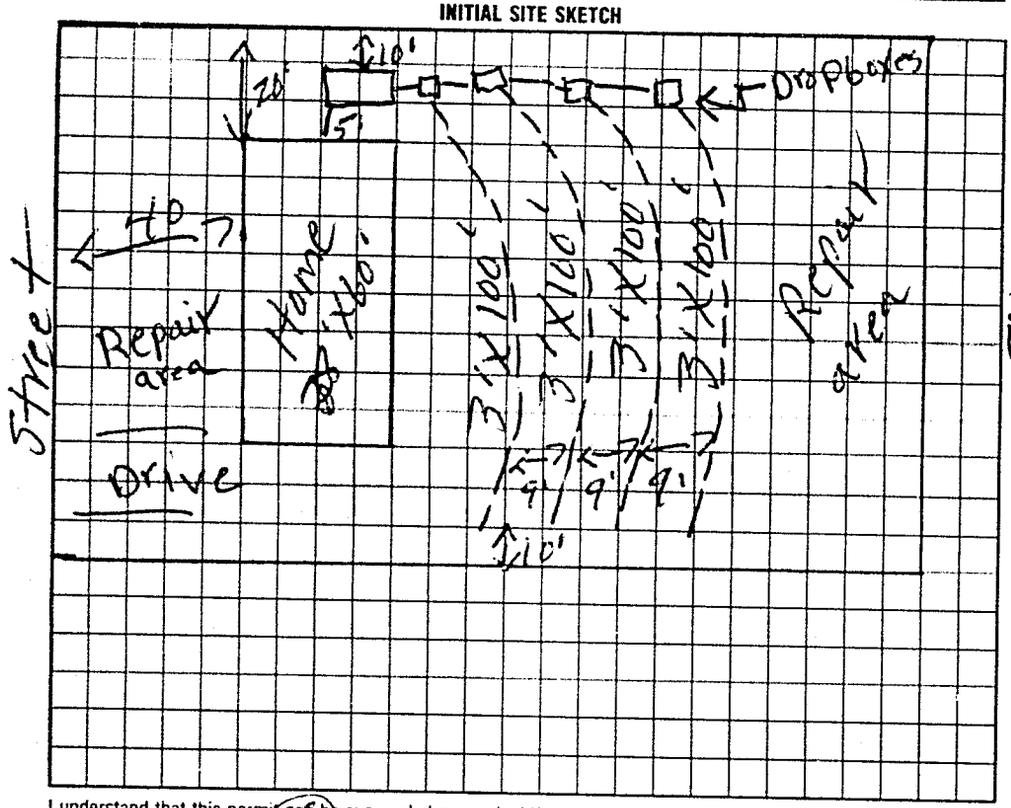

AS BUILT SKETCH

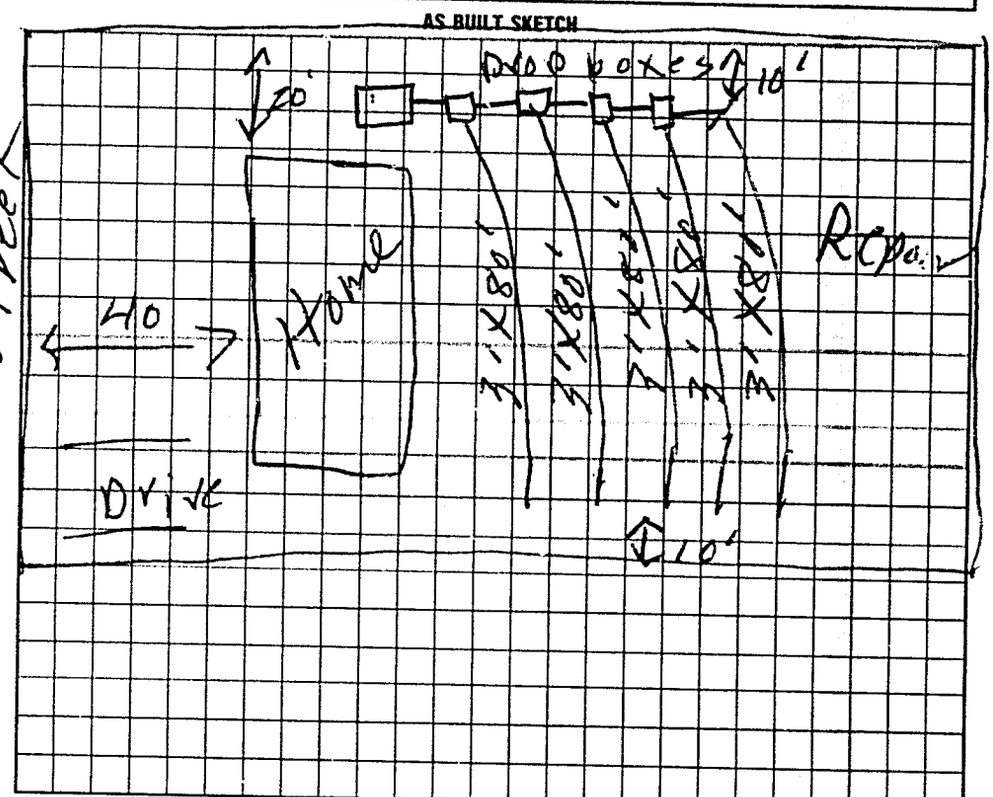

I understand that this permit can be suspended or revoked if any false information is supplied toward securing the permit/any unauthorized changes are made to the site/any unauthorized changes are made in the installation of the system. Improvement Permit is valid for 60 months from date of issuance.

Signed:

Improvement Permit by: P. C. Moore date 3-3-97

Authorization to Cover Existing System Inspection by: P. C. Moore date 3-3-97

Installed by: Donald Tacker

Certificate of Completion by: date

Operation Permit by P. C. Moore date 11-13-98

HEALTH DEPT. COPY: WHITE INSPECTION COPY (FINAL): GREEN OWNER COPY (FINAL): YELLOW INSPECTION COPY (INITIAL): PINK OWNER COPY (INITIAL): GOLD

to Court. Authorization to Court EXPIRES COMES From ISSUE

$1500