IREDELL COUNTY HEALTH DEPARTMENT

STATESVILLE 704-878-5305 MOORESVILLE 704-664-5281

IMPROVEMENT PERMIT / CERTIFICATE OF COMPLETION / OPERATION PERMIT / EXISTING SYSTEM INSPECTION

PROPERTY DESCRIPTION NO. 26037 DATE 5-1-97 TAX MAP NO. 4763573335 Watershed: ☐ Yes ☑ No

OWNER OR CONTRACTOR T+T co Inc. PHONE: Business 878 6660 Home

ADDRESS 849 Bell Fm Rd

LOCATION Bell Fm Rd Turn oakcreek TR Teak Rd

SUBDIVISION OakCreekPl BLOCK / SECTION LOT 385 LOT AREA .4545 SITE CLASS. P3 DESIGN FLOW 360 L.T.A.R. .28

Septic Tank: 1000 Gallons; STB 1017 Date 5-23-98

Pump Tank: Gallons; PT Date

Pump Make: Model Serial No.

Nitrification Field: No Fields 1 Square Feet 1080 Linear Feet 360

No Lines 5 Trench Width 36 Max Trench Bottom Depth 36 Gravel Depth N/A

☐ New System ☐ Repair System Type: I, II, III, IV, V, VI

System Description: Gravity chambers

Repair System Description: Pump to chambers

Maintenance Agreement Required: ☐ Yes ☑ No

☐ House/Mod. Home No. Bedrooms 3

☑ Mobile Home No. Bathrooms 2

☐ Business No. Employees

☐ Other


☐ Slab ☑ Crawl Space ☐ Basement w/plumbing ☐ Basement wo/plumbing

Water Supply: ☐ Individual ☐ Community ☐ Public

Comments:

Comments: keep water line minimum 10' from any part of septic tank system

INITIAL SITE SKETCH

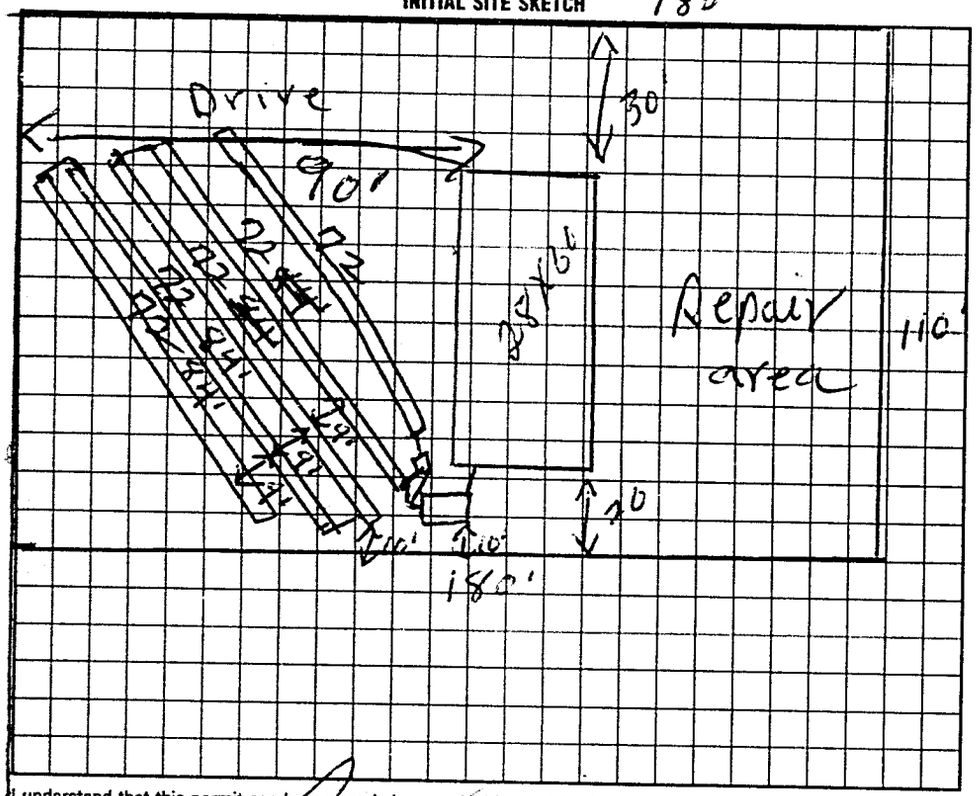

AS BUILT SKETCH

Same as initial sketch

I understand that this permit can be suspended or revoked if any false information is supplied toward securing the permit/any unauthorized changes are made to the site/any unauthorized changes are made in the installation of the system. Improvement Permit is valid for 60 months from date of issuance.

Signed:

Improvement Permit by: P. C. Moore date 5-1-97

Existing System Inspection by: P. C. Moore date 5-1-97

Installed by: Donalt Lackey

Certificate of Completion by: date

Operation Permit by: P. C. Moore date 7-24-98

TO CONTRACTOR COPY: WHITE INSPECTION COPY (FINAL): GREEN OWNER COPY (FINAL): YELLOW INSPECTION COPY (INITIAL): PINK OWNER COPY (INITIAL): GOLD

Authorization to count. Expires 60 mos from issue

6 2 5 1