IREDELL COUNTY HEALTH DEPARTMENT

STATESVILLE 704-878-5305 MOORESVILLE 704-664-5281

IMPROVEMENT PERMIT / CERTIFICATE OF COMPLETION / OPERATION PERMIT / EXISTING SYSTEM INSPECTION

PROPERTY DESCRIPTION NO. 26035 06143 DATE 10-23-97 TAX MAP NO. 4763 57 3335 Watershed: ☐ Yes ☑ No

OWNER OR CONTRACTOR T+T Inc PHONE: Business 878-6660 Home

ADDRESS 349 Bell Rd Statesville

LOCATION Bell Rd Turn on Oak Creek (TL) Lots 386 TR Teak 1st lot on R

SUBDIVISION Oak Creek BLOCK / SECTION LOT 386 LOT AREA .93 acres SITE CLASS. PS DESIGN FLOW 360 L.T.A.R. .3

Septic Tank: 1000 Gallons; STB 1012 Date 7-10-98
Pump Tank: Gallons; PT Date
Pump Make: Model Serial No.
Nitrification Field: No Fields 1 Square Feet 900 Linear Feet 300
No Lines 3 Trench Width 36" Max Trench Bottom Depth 36" Gravel Depth N/A

☑ New System ☐ Repair System Type: I, II, III, IV, V, VI
System Description: Gravity chambers
Repair System Description: Pump To Chambers
Maintenance Agreement Required: ☐ Yes ☐ No

☐ House/Mod. Home ☑ Mobile Home ☐ Business ☐ Other
No. Bedrooms 3 No. Bathrooms 2 No. Employees


☐ Slab ☑ Crawl Space ☐ Basement w/plumbing ☐ Basement wo/plumbing

Water Supply: ☐ Individual ☐ Community ☑ Public

Comments: Combining Two lots To make Done building site
Replaces Permit Issued To lot 386

Comments:

INITIAL SITE SKETCH

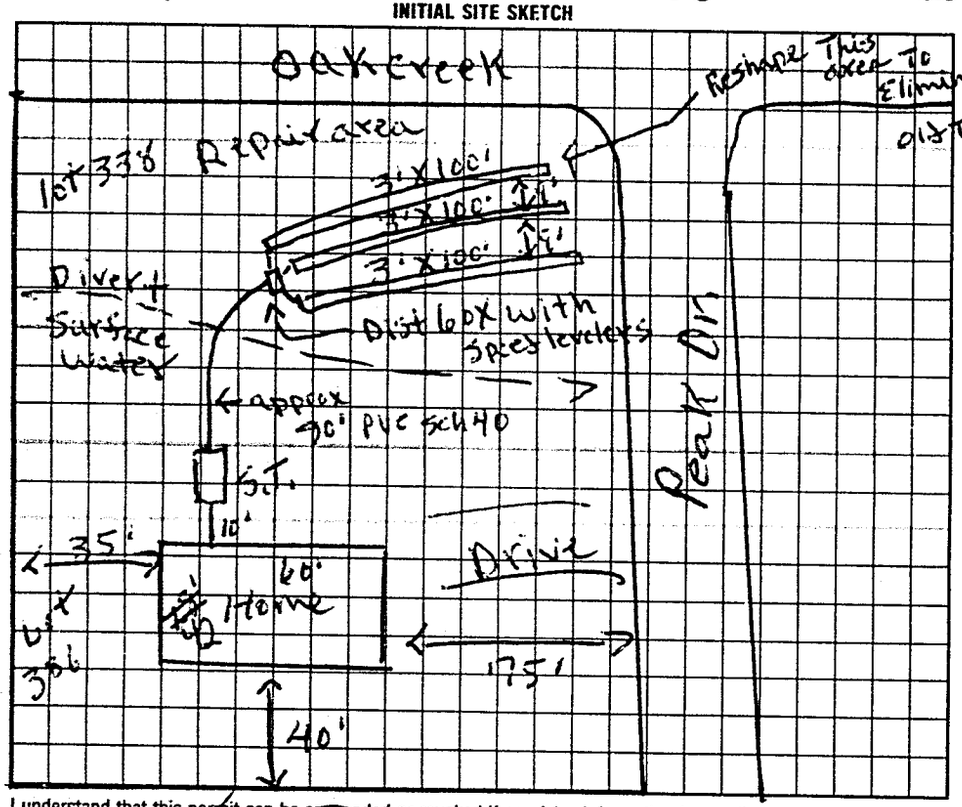

AS BUILT SKETCH

Installed as shown

I understand that this permit can be suspended or revoked if any false information is supplied toward securing the permit/any unauthorized changes are made to the site/any unauthorized changes are made in the installation of the system. Improvement Permit is valid for 60 months from date of issuance.

Signed: Ray McCown

Improvement Permit by: L.C. moore date 10-23-97

Authorization to Existing System Inspection by: L.C. moore date 10-23-97

Installed by: Donald Lackey

Certificate of Completion by: date

Operation Permit by: Mat C Off RS date 4-15-98

HEALTH DEPT. COPY WHITE INSPECTION COPY (FINAL) GREEN OWNER COPY (FINAL) YELLOW INSPECTION COPY (INITIAL) PINK OWNER COPY (INITIAL) GOLD

Authorization to Count Expires 60 mos from issue to count.

9 0 5 0 0 0