Lot 157 on Computer

IREDELL COUNTY HEALTH DEPARTMENT

STATESVILLE 704-878-5305 MOORESVILLE 704-664-5281

IMPROVEMENT PERMIT / CERTIFICATE OF COMPLETION / OPERATION PERMIT / EXISTING SYSTEM INSPECTION

PROPERTY DESCRIPTION NO. 22317 DATE 11-8-95 TAX MAP NO. 5m-A-15? Pt of Watershed: ☐ Yes ☐ No

OWNER OR CONTRACTOR T+T Co. PHONE: Business 878-6660 Home

ADDRESS PO Box 1835 Statesville

LOCATION Hwy 70E TL Bell Rd TR Oak Creek Rd on left Past English Ln.

SUBDIVISION Oak Creek BLOCK / SECTION 2 LOT 32? LOT AREA 1 acre+ SITE CLASS. PS DESIGN FLOW 360 L.T.A.R. 130

Septic Tank: 1000 Gallons; STB 1012 Date 9-29-95

Pump Tank: Gallons; PT Date

Pump Make: Model Serial No.

Nitrification Field: No Fields 1 Square Feet 1200 Linear Feet 400

No Lines 4 Trench Width 30" 36" Max Trench Bottom Depth 36" Gravel Depth 12"

☐ New System ☐ Repair System Type: I, II, III, IV, V, VI

System Description: Conv. Gravity

Repair System Description:

Maintenance Agreement Required: ☐ Yes ☐ No

☐ Slab ☐ Crawl Space ☐ Basement w/plumbing ☐ Basement wo/plumbing

☐ House/Mod. Home No. Bedrooms 3


☐ Mobile Home No. Bathrooms 2

☐ Business No. Employees

☐ Other

Water Supply: ☐ Individual ☐ Community ☐ Public


Comments:

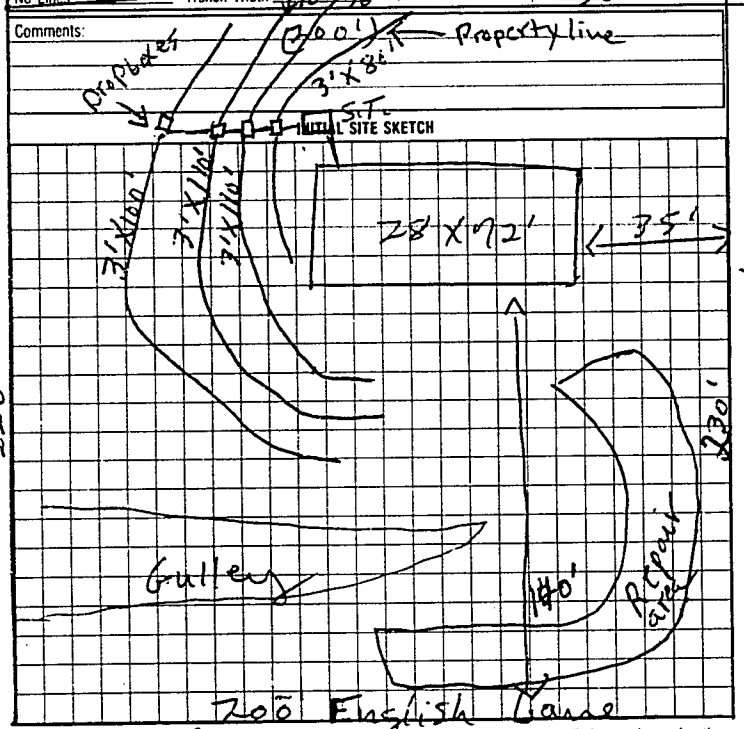

220'

Comments:

AS BUILT SKETCH

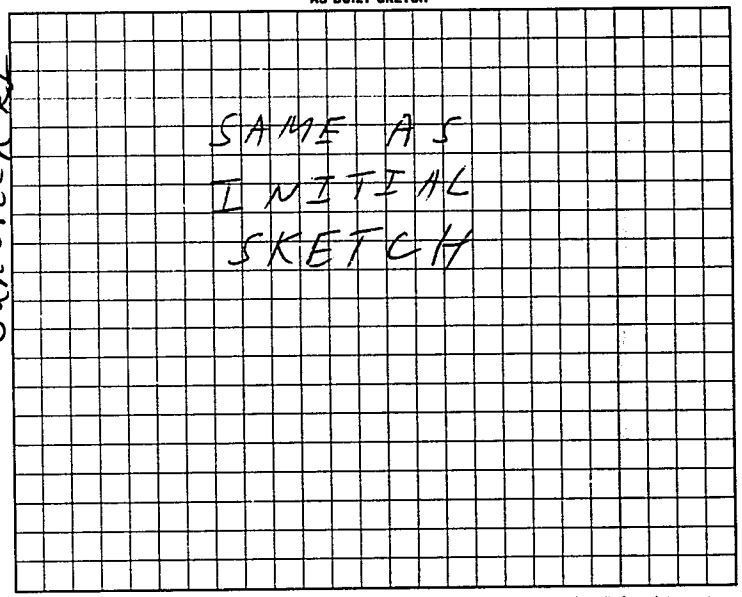

I understand that this permit can be suspended or revoked if any false information is supplied toward securing the permit/any unauthorized changes are made to the site/any unauthorized changes are made in the installation of the system.

Signed: X

Improvement Permit by: P.C. Moore date 11-8-95

Authorization by P.C. Moore date 11-8-95

Installed by: Donald Lackey

Certificate of Completion by: date

Operation Permit by: P.C. Moore date 12-12-95

Authorization to Const

HEALTH DEPT. COPY. WHITE INSPECTION COPY (FINAL) GREEN OWNER COPY (FINAL) YELLOW INSPECTION COPY (INITIAL) PINK OWNER COPY (INITIAL) GOLD

Authorization to Const Expires 60 months from date of issue

166100