IREDELL COUNTY HEALTH DEPARTMENT

STATESVILLE 704-878-5305 MOORESVILLE 704-664-5281

IMPROVEMENT PERMIT / CERTIFICATE OF COMPLETION / OPERATION PERMIT / EXISTING SYSTEM INSPECTION

PROPERTY DESCRIPTION NO. 26009 DATE 5-1-97 TAX MAP NO. 4763 57 3335

OWNER OR CONTRACTOR H-T Co Inc. PHONE: Business 8786660 Home

ADDRESS 849 Bell Fm Rd Watershed: ☐ Yes ☒ No

LOCATION Bell Fm Rd Turn Oak Creek Rd Corner of Teak Dr.

SUBDIVISION Oak Creek BLOCK / SECTION LOT 337 LOT AREA 1.4771 acres SITE CLASS. PS DESIGN FLOW 360 L.T.A.R. 1.3

Septic Tank: 1000 Gallons; STB 1612 Date 3-28-97

Pump Tank: Gallons; PT Date

Pump Make: Model Serial No.

Nitrification Field: No Fields 1 Square Feet 1200 Linear Feet 400

No Lines 3 Trench Width 36" Max Trench Bottom Depth 36" Gravel Depth 12"

☒ New System ☐ Repair System Type: I, II, III, IV, V, VI

System Description: Conv. Gravity

Repair System Description: Chambers

Maintenance Agreement Required: ☐ Yes ☒ No

☐ House/Mod. Home No. Bedrooms 3

☒ Mobile Home No. Bathrooms 2

☐ Business No. Employees

☐ Other


☐ Slab ☒ Crawl Space ☐ Basement w/plumbing ☐ Basement wo/plumbing

Water Supply: ☐ Individual ☐ Community ☒ Public


Comments:

Comments:

INITIAL SITE SKETCH

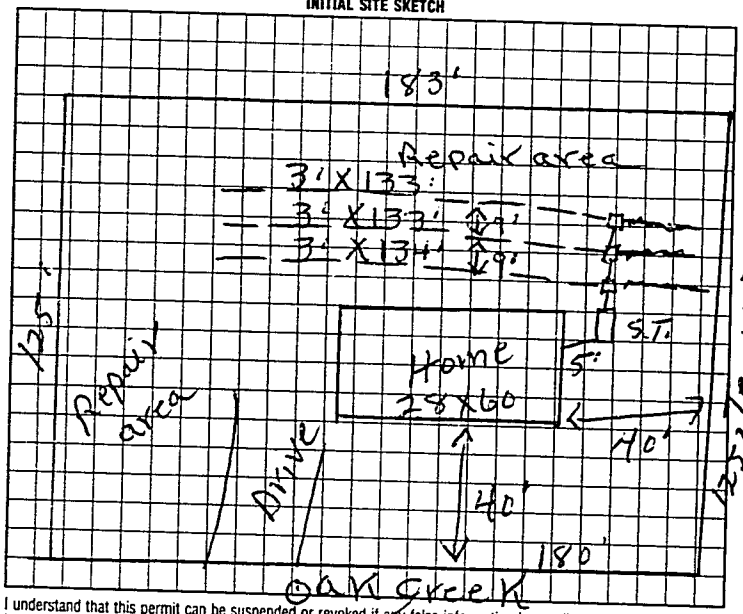

AS BUILT SKETCH

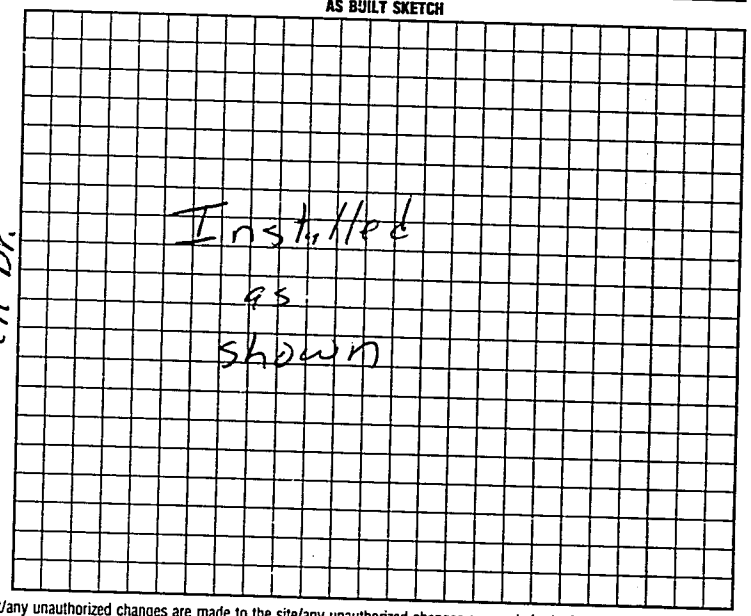

I understand that this permit can be suspended or revoked if any false information is supplied toward securing the permit/any unauthorized changes are made to the site/any unauthorized changes are made in the installation of the system. Improvement Permit is valid for 60 months from date of issuance.

Signed: Tom Dorsey

Improvement Permit by: R. C. Moore date 5-1-97

Authorization to Existing System Inspection by: R. C. Moore date 5-1-97

Installed by: Donald Lackey

Certificate of Completion by: date

Operation Permit by: Mark C. Outlaw date 5-27-97

HEALTH DEPT. COPY: WHITE INSPECTION COPY (FINAL): GREEN OWNER COPY (FINAL): YELLOW INSPECTION COPY (INITIAL): PINK OWNER COPY (FINAL): GOLD

Authorization to Const EXPIRES 60 MOS FROM ISSUE