pd $125 11-6-97 4:00 Donald Lacky

IREDELL COUNTY HEALTH DEPARTMENT

STATESVILLE 704-878-5305 MOORESVILLE 704-664-5281

IMPROVEMENT PERMIT / CERTIFICATE OF COMPLETION / OPERATION PERMIT / EXISTING SYSTEM INSPECTION

PROPERTY DESCRIPTION NO. 700 36 DATE 10-21-97 TAX MAP NO. 4763691206 Watershed: ☐ Yes ☐ No

OWNER OR CONTRACTOR T+T Co Inc. PHONE: Business 876 6660 Home

ADDRESS 849 Bell Farm Rd. Statesville

LOCATION 70 E TL Bell Rd 0.9 mi Rt. (2ND) LOT ON (R) PAST OAK CREEK DRIVE

SUBDIVISION Oak Creek BLOCK / SECTION LOT 319 LOT AREA .48 acres SITE CLASS. PS DESIGN FLOW 360 L.T.A.R. .3

Septic Tank: 1000 Gallons; STB 1012 Date 8-29-97

Pump Tank: Gallons; PT Date

Pump Make: Model Serial No.

Nitrification Field: No Fields 1 Square Feet 900 Linear Feet 300

No Lines 4 Trench Width 36" Max Trench Bottom Depth 36" Gravel Depth N/A

☑ New System ☐ Repair System Type: I, II, III, IV, V, VI

System Description: Gravity Chamber or

Repair System Description: Pump to Chambers HDS

Maintenance Agreement Required: ☐ Yes ☐ No

☐ House/Mod. Home ☑ Mobile Home ☐ Business ☐ Other

No. Bedrooms 3 No. Bathrooms 2 No. Employees


☐ Slab ☑ Crawl Space ☐ Basement w/plumbing ☐ Basement wo/plumbing

Water Supply: ☐ Individual ☐ Community ☑ Public


Comments:

Comments:

INITIAL SITE SKETCH

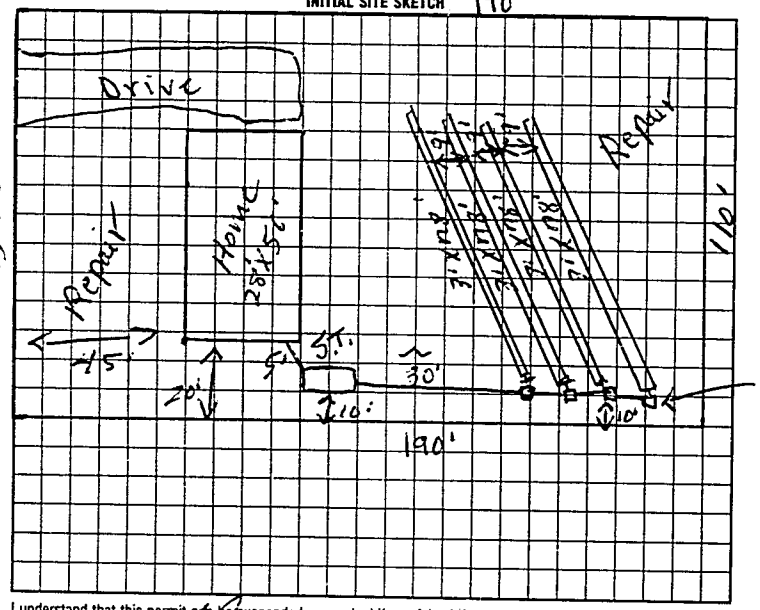

AS BUILT SKETCH

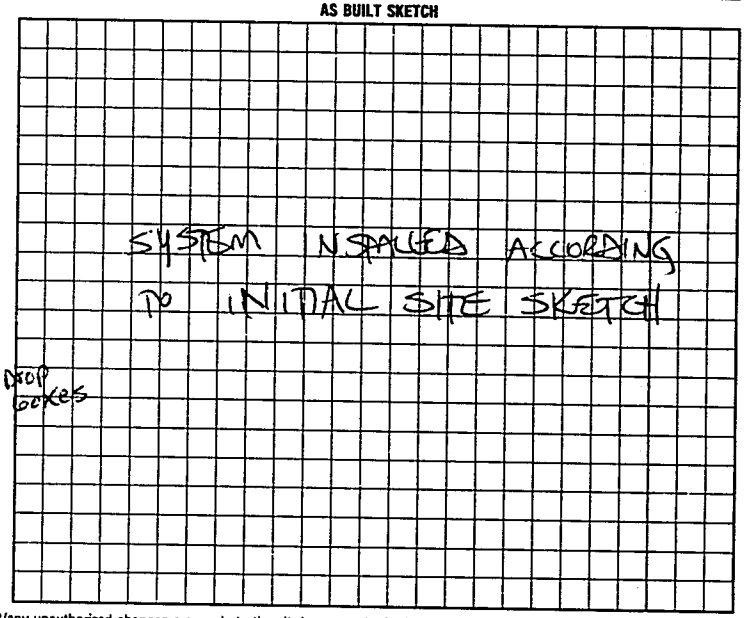

I understand that this permit can be suspended or revoked if any false information is supplied toward securing the permit/any unauthorized changes are made to the site/any unauthorized changes are made in the installation of the system. Improvement Permit is valid for 60 months from date of issuance.

Signed:

Improvement Permit by: R. C. Moore date 11-21-97

Authorization to Existing System Inspection by: R. C. Moore date 10-21-97

Authorization to cont.

Installed by: DONALD LACKEY

Certificate of Completion by: date

Operation Permit by: STEVE HEDRICK date 11-25-97

Authorization to cont. EXPIRES 60 mos from issue

HEALTH DEPT COPY (WHITE) INSPECTION COPY (FINAL): GREEN OWNER COPY (FINAL): YELLOW INSPECTION COPY (INITIAL): PINK OWNER COPY (INITIAL): GOLD

668200