Gary Grissom

6/815

IREDELL COUNTY HEALTH DEPARTMENT

STATESVILLE 704-878-5305 MOORESVILLE 704-664-5281

IMPROVEMENT PERMIT / CERTIFICATE OF COMPLETION / OPERATION PERMIT / EXISTING SYSTEM INSPECTION

PROPERTY DESCRIPTION NO. 23446 DATE 4-1-96 TAX MAP NO. 5m-A-43 Watershed: ☐ Yes ☐ No

OWNER OR CONTRACTOR T+T Co. PHONE: Business 878-6660 Home

ADDRESS Box Box 1435

LOCATION 70E TL Bell Rd TR Oak Creek TL English 2nd lot left

SUBDIVISION Oak Creek BLOCK / SECTION LOT 323 LOT AREA .45 acres SITE CLASS. PS DESIGN FLOW 360 L.T.A.R. .3

Septic Tank: 1000 Gallons; STB 1012 Date 4-30-96

Pump Tank: Gallons; PT Date

Pump Make: Model Serial No.

Nitrification Field: No Fields 1 Square Feet 900 Linear Feet 300

No Lines 3 Trench Width 36" Max Trench Bottom Depth 36" Gravel Depth N/A

☑ New System ☐ Repair System Type. I. II. III. IV. V. VI

System Description: Gravity Chamber Gravities

Repair System Description:

Maintenance Agreement Required: ☐ Yes ☑ No

☐ House/Mod. Home No. Bedrooms 3

☑ Mobile Home No. Bathrooms 2

☐ Business No. Employees

☐ Other


☐ Slab ☐ Crawl Space ☐ Basement w/plumbing ☐ Basement wo/plumbing

Water Supply: ☐ Individual ☐ Community ☑ Public

Comments:

Comments:

INITIAL SITE SKETCH

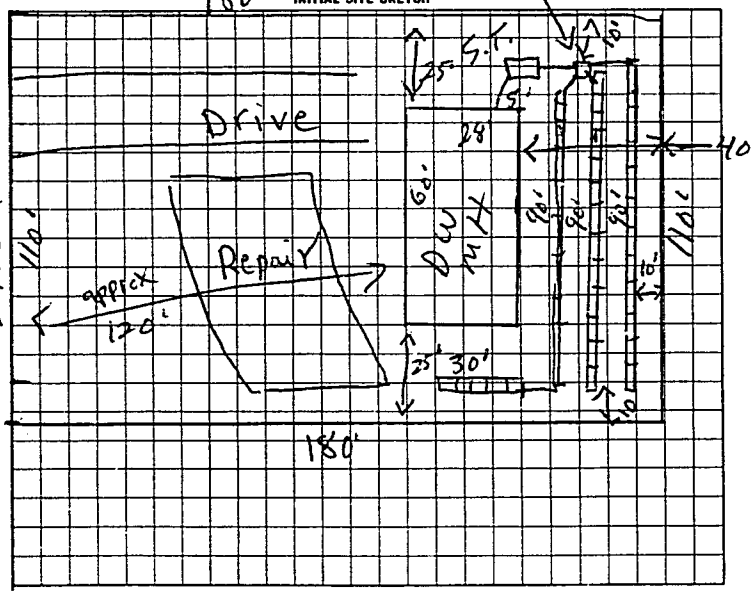

AS BUILT SKETCH

Same as initial sketch

I understand that this permit can be suspended or revoked if any false information is supplied toward securing the permit/any unauthorized changes are made to the site/any unauthorized changes are made in the installation of the system.

Signed: T+T Co. By: [illegible]

Improvement Permit by: P. C. Moore date 4-1-96

Authorization to Occupy Existing System Inspected by P. C. Moore date 4-1-96

Installed by: Donald Fackrell

Certificate of Completion by: date

Operation Permit by P. C. Moore date 7-3-96

+0 count HEALTH DEPT. COPY WHITE INSPECTION COPY (FINAL) GREEN OWNER COPY (FINAL) YELLOW INSPECTION COPY (INITIAL) PINK OWNER COPY (INITIAL) GOLD

Authorization to count. Expires 60 mos from issue

105200