1:00

# IREDELL COUNTY HEALTH DEPARTMENT

STATESVILLE 704-878-5305 MOORESVILLE 704-664-5281

## IMPROVEMENT PERMIT / CERTIFICATE OF COMPLETION / OPERATION PERMIT / EXISTING SYSTEM INSPECTION

PROPERTY DESCRIPTION NO. 22315 DATE 12-19-95 TAX MAP NO. 5m-A-15n Pt of Watershed: ☐ Yes ☑ No

OWNER OR CONTRACTOR T+T Co. PHONE: Business 878 6660 Home

ADDRESS Po Box 1835 Sta

LOCATION US 70 E TL Bell Rd on Rt before Bellwood Dr.

SUBDIVISION Oak Creek BLOCK / SECTION LOT 318 LOT AREA .5108 acres SITE CLASS. PS DESIGN FLOW 360 L.T.A.R. .3

Septic Tank: 1000 Gallons; STB 1012 Date 1-28-96

Pump Tank: Gallons; PT Date

Pump Make: Model Serial No.

Nitrification Field: No Fields 1 Square Feet 900 Linear Feet 300

No Lines 4 Trench Width 36" Max Trench Bottom Depth 36" Gravel Depth N/A

☑ New System ☐ Repair System Type: I, II, III, IV, V, VI

System Description: Gravity chambers

Repair System Description: Pump To PPBS

Maintenance Agreement Required: ☐ Yes ☑ No

☐ House/Mod. Home ☑ Mobile Home ☐ Business ☐ Other

No. Bedrooms 3 No. Bathrooms 2 No. Employees


☐ Slab ☑ Crawl Space ☐ Basement w/plumbing ☐ Basement wo/plumbing

Water Supply: ☐ Individual ☐ Community ☐ Public


Comments:

Comments:

INITIAL SITE SKETCH 1971

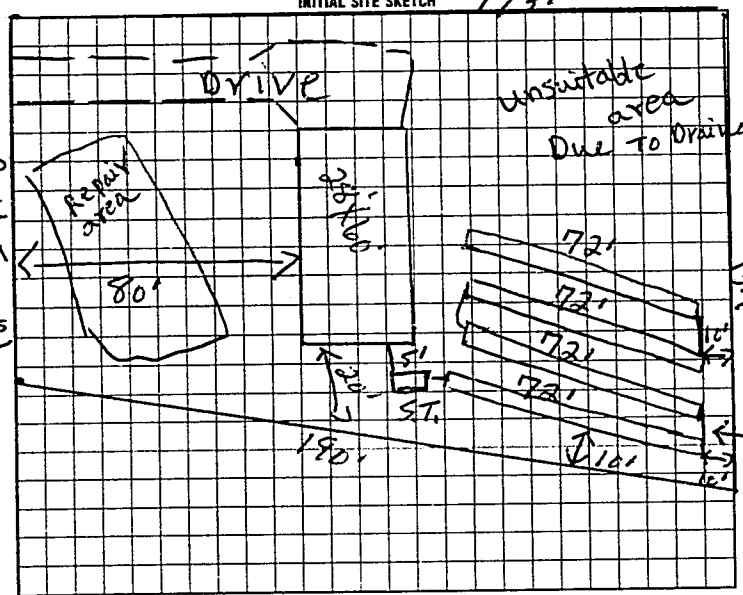


AS BUILT SKETCH

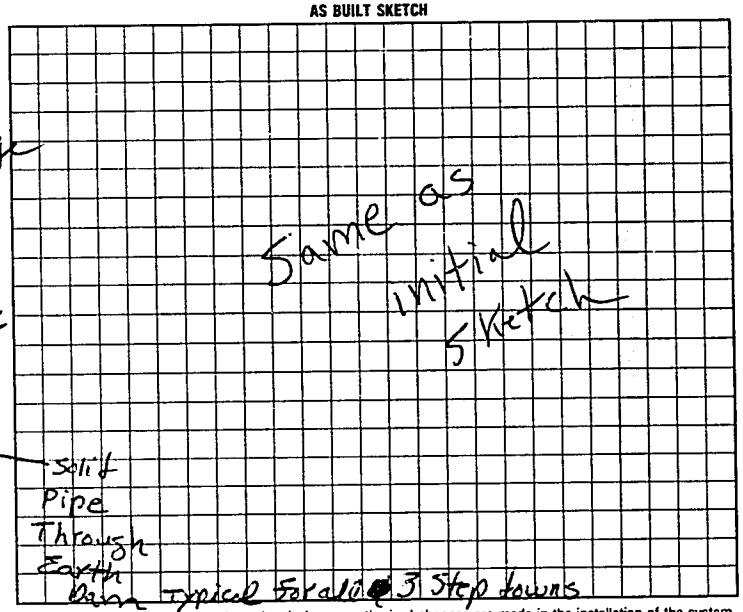


I understand that this permit can be suspended or revoked if any false information is supplied toward securing the permit/any unauthorized changes are made to the site/any unauthorized changes are made in the installation of the system.

Signed: T+T Co. by Joe Thaler

Improvement Permit by: R.C. moore date 12-19-95

Authorization to Const Existing System Inspection by: R.C. moore date 12-19-95

Installed by: Donald Lackey

Certificate of Completion by: date

Operation Permit by: R.C. moore date 4-3-96

HEALTH DEPT COPY WHITE INSPECTION COPY (FINAL) GREEN OWNER COPY (FINAL) YELLOW INSPECTION COPY (INITIAL) PINK OWNER COPY (INITIAL) GOLD

Authorization to Const Expires 60 months from date of issue

961200