IREDELL COUNTY HEALTH DEPARTMENT

STATESVILLE 704-878-5305 MOORESVILLE 704-664-5281 (300)

IMPROVEMENT PERMIT / AUTHORIZATION TO CONSTRUCT / OPERATION PERMIT / EXISTING SYSTEM INSPECTION

PERMIT# 88420 PIN# 4763 '61420)

OWNER OR CONTRACTOR TSUMAS FAMILY LTD PHONE: Business Home DATE 5/17/00

ADDRESS 300 E BROAD ST STATESVILLE

LOCATION 70E - TL BELL FARM - TR OAK CREEK - TL ENGLISH - MTFN

SUBDIVISION OAK CREEK BLOCK / SECTION 2 LOT 325 LOT AREA .62AC SITE CLASS KS DESIGN FLOW 360gpd L.T.A.R. .3gpd/ft²

Septic Tank: 1000 Gallons; STB 825 Date 5/16/00
Pump Tank: Gallons; PT Date
Pump Make: Model Serial No.
Nitrification Field: No Fields 1 Square Feet 1200 Linear Feet 400
No Lines 4@100' Trench Width 36" Max Trench Bottom Depth 36" Gravel Depth 12"

☑ New System ☐ Repair System Type: I II III IV V VI
System Description: CONVENTIONAL
Repair System Description: LPP AV PLANT INNOVATIVE
Maintenance Agreement Required: ☐ Yes ☑ No
☐ Slab ☑ Crawl Space ☐ Basement w/plumbing ☐ Basement wo/plumbing


☐ House/Mod. Home No. Bedrooms 3
☑ Mobile Home No. Bathrooms 2
☐ Business No. Employees
☐ Other

Water Supply: ☐ Individual ☑ Public ☐ Community

Comments:/Conditions:

Comments:/Conditions:

1"=30' INITIAL SITE SKETCH

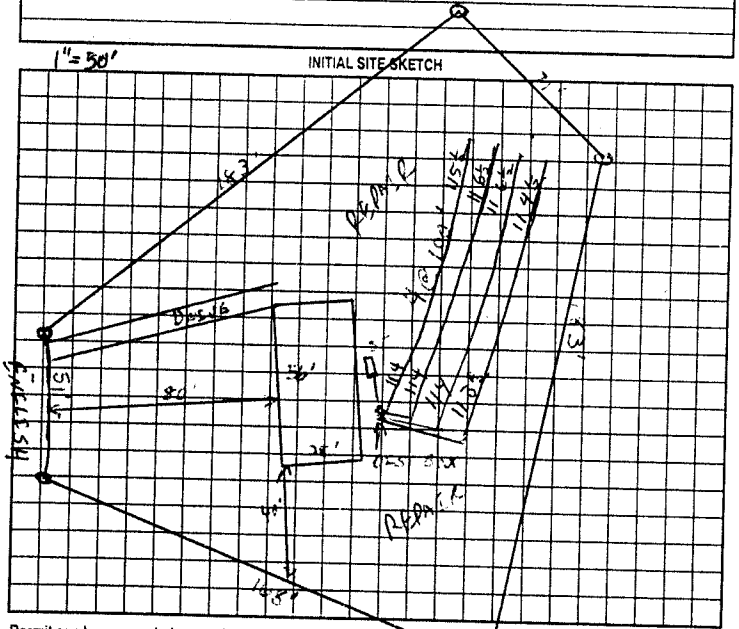

AS BUILT SKETCH

Permit can be suspended or revoked if any false information is supplied toward securing the permit/any unauthorized changes are made to the site/any unauthorized changes are made in the installation of the system. Improvement Permit with plat valid without expiration. Improvement Permit with site plan valid for sixty months. Authorization to Construct is valid for a period equal to that of Improvement Permit – not to exceed sixty months.

Signed: Katy Cobb date 5-22-00

Improvement Permit by: C. Lyn KS date 5/17/00

Authorization to Construct by: C. Lyn KS date 5/17/00

Installed by: ROWAN SEPTIC

Operation Permit by: C. Lyn KS date 8/25/00

Existing System Inspection by: date

HEALTH DEPT. COPY. WHITE OWNER COPY (FINAL). YELLOW OWNER COPY (INITIAL). PINK