41342

IREDELL COUNTY HEALTH DEPARTMENT

STATESVILLE 704-878-5305 MOORESVILLE 704-664-5281

IMPROVEMENT PERMIT / CERTIFICATE OF COMPLETION / OPERATION PERMIT / EXISTING SYSTEM INSPECTION

TAX MAP NO. 5H-2-A-24L

PROPERTY DESCRIPTION NO. 15482 DATE 6-3-93 PHONE: Business 8785660 Home

OWNER OR CONTRACTOR T+T Inc.

ADDRESS Bethesda Rd

LOCATION 70E TR marshal TR oltwell Dr. TL Big Forest Rd Turn left 2nd st at end

SUBDIVISION Forest Acres BLOCK / SECTION V LOT 239 LOT AREA 3/4 ac +/- SITE CLASS. L.T.A.R.

Water Supply: ☐ Individual ☐ Community ☑ Public

Septic Tank: 1000 Gallons; STB 1782 Date 4-10-93

Pump Tank: Gallons; PT Date

Nitrification Field: No. Fields 1 Square Feet 1080 Linear Feet 360

No. Lines 4 Trench Width 36 Trench Depth 36" Gravel Depth 12"

☑ New System ☐ Repair System Type: I, II, III, IV, V, VI

System Description: Conv. Gravity

Repair System Description:

Maintenance Agreement Required: ☐ Yes ☑ No

☐ House/Mod. Home ☑ Mobile Home ☐ Business ☐ Other

No. Bedrooms 3 No. Bathrooms 2 No. Employees

Garbage Disposal: ☐ Yes ☑ No

Auto. Dishwasher: ☐ Yes ☑ No

Auto. Washing Machine: ☑ Yes ☐ No


Other

☐ Slab ☑ Crawl Space ☐ Basement w/plumbing ☐ Basement wo/plumbing

Comments

INITIAL SITE SKETCH

AS BUILT SKETCH

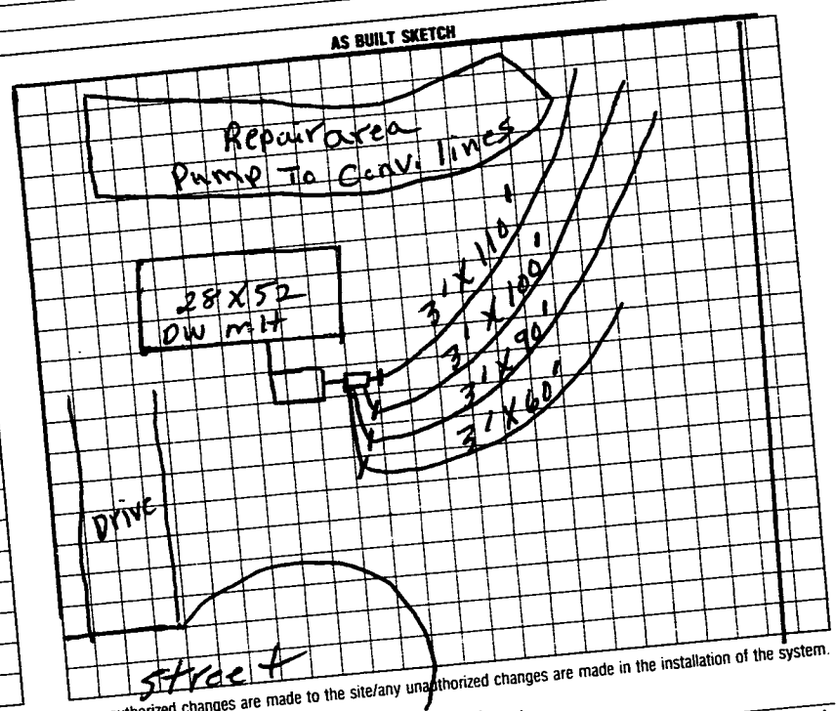

I understand that this permit can be suspended or revoked if any false information is supplied toward securing the permit/any unauthorized changes are made to the site/any unauthorized changes are made in the installation of the system. Improvement Permit is valid for 60 months from date of issuance.

Signed:

Improvement Permit by: L.C. moore date 5-3-93

Existing System Inspection by: date

Installed by: Donald Lackey

Certificate of Completion by: L.C. moore date 6-3-93

Operation Permit by: date

HEALTH DEPT. COPY: WHITE INSPECTION COPY (FINAL): GREEN OWNER COPY (FINAL): YELLOW INSPECTION COPY (INITIAL): PINK OWNER COPY (INITIAL): GOLD