48656

IREDELL COUNTY HEALTH DEPARTMENT

STATESVILLE 704-878-5305 MOORESVILLE 704-664-5281

IMPROVEMENT PERMIT / CERTIFICATE OF COMPLETION / OPERATION PERMIT / EXISTING SYSTEM INSPECTION

PROPERTY DESCRIPTION NO. 15535 DATE 8-24-93 TAX MAP NO. 5K-7-A-230

OWNER OR CONTRACTOR T+T INC. PHONE: Business 878-6660 Home 5K-7-A-230

ADDRESS PO Box 288 Sta.

LOCATION 705 TR Morehead TR well Hse Dr. TL Big Forest Drive at corner ~~Tulip~~ Cedar Ct.

SUBDIVISION Forest Acres BLOCK / SECTION V LOT ~~5~~ 237 LOT AREA 120'x180'0 SITE CLASS. P.S. L.T.A.R. .35

Water Supply: ☐ Individual ☐ Community ☑ Public

Septic Tank: 1000 Gallons; STB 358 Date 6/23/93

Pump Tank: _____ Gallons; PT _____ Date _____

Nitrification Field: No Fields 1 Square Feet 1035 Linear Feet 345

No Lines 3 Trench Width 36 Trench Depth 18+36 Gravel Depth 12

☑ New System ☐ Repair System Type: I, II, III, IV, V, VI

System Description: Conv. Gravity

Repair System Description: " "

Maintenance Agreement Required: ☐ Yes ☑ No

☐ House/Mod. Home No. Bedrooms 3 Garbage Disposal: ☐ Yes ☑ No

☐ Mobile Home No. Bathrooms 2 Auto. Dishwasher: ☐ Yes ☑ No


☐ Business No. Employees _____ Auto. Washing Machine: ☑ Yes ☐ No

☐ Other _____ Other _____

☐ Slab ☑ Crawl Space ☐ Basement w/plumbing ☐ Basement wo/plumbing

Comments _____

INITIAL SITE SKETCH

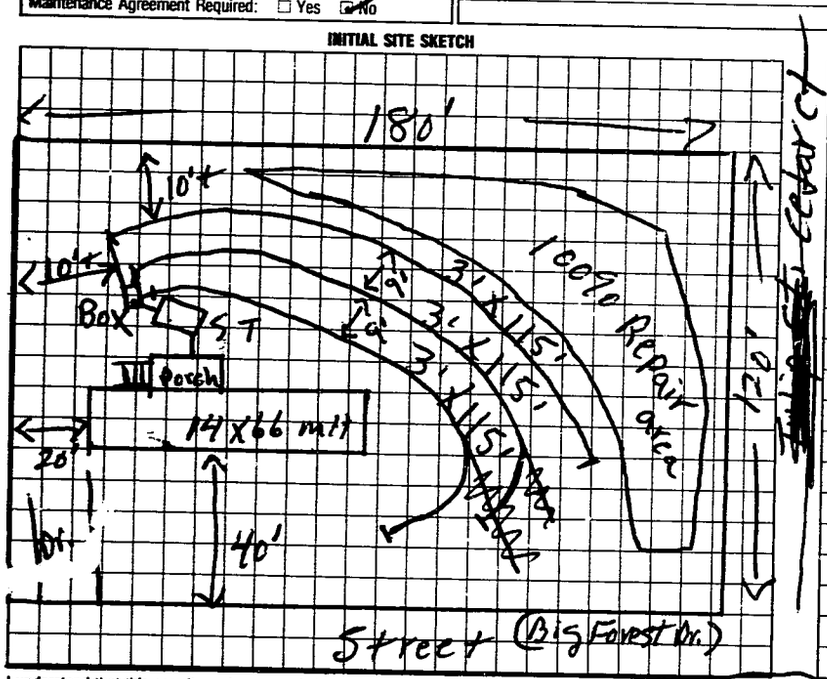

AS BUILT SKETCH

SYSTEM INSTALLED ACCORDING TO INITIAL SITE SKETCH

I understand that this permit can be suspended or revoked if any false information is supplied toward securing the permit/any unauthorized changes are made to the site/any unauthorized changes are made in the installation of the system. Improvement Permit is valid for 60 months from date of issuance.

Signed: T+T Co., by J. Thaler, agent for Buyers

Improvement Permit by: P. C. Moore date 8-24-93

Existing System Inspection by: _____ date _____

Installed by: DONALD LACKEY

Certificate of Completion by: STEVE HOAACK date 9/10/93

Operation Permit by: _____ date _____

HEALTH DEPT. COPY: WHITE INSPECTION COPY (FINAL): GREEN OWNER COPY (FINAL): YELLOW INSPECTION COPY (INITIAL): PINK OWNER COPY (INITIAL): GOLD