IREDELL COUNTY HEALTH DEPARTMENT

STATESVILLE 704-878-5305 MOORESVILLE 704-664-5281

IMPROVEMENT PERMIT / CERTIFICATE OF COMPLETION / OPERATION PERMIT / EXISTING SYSTEM INSPECTION

PROPERTY DESCRIPTION NO. 15538 DATE 5-25-94 TAX MAP NO. 5K-7-A-235 Watershed: ☐ Yes ☑ No

OWNER OR CONTRACTOR T+T Co. PHONE: Business 878 6660 Home

ADDRESS 70E TR morehead TR oldwell Dr TL Big Forest TR Tulip Tree Ct on Rt

LOCATION

SUBDIVISION Forest Acres BLOCK / SECTION IV LOT 235 LOT AREA .436 acres SITE CLASS. P5 DESIGN FLOW 240 L.T.A.R. .35

Septic Tank: 1000 Gallons; STB 1012 Date 3-14-94
Pump Tank: Gallons; PT Date
Pump Make: Model Serial No.
Nitrification Field: No Fields 1 Square Feet 240 Linear Feet 720
No Lines 3 Trench Width 36" Max Trench Bottom Depth 36" Gravel Depth 12"

☑ New System ☐ Repair System Type: I (II) III, IV, V, VI
System Description: Conv. Gravity
Repair System Description: " "
Maintenance Agreement Required: ☐ Yes ☑ No


☐ House/Mod. Home No. Bedrooms 2
☑ Mobile Home No. Bathrooms 2
☐ Business No. Employees
☐ Other
☐ Slab ☑ Crawl Space ☐ Basement w/plumbing ☐ Basement wo/plumbing

Water Supply:
☐ Individual
☐ Community
☑ Public

Comments:

Comments:

INITIAL SITE SKETCH

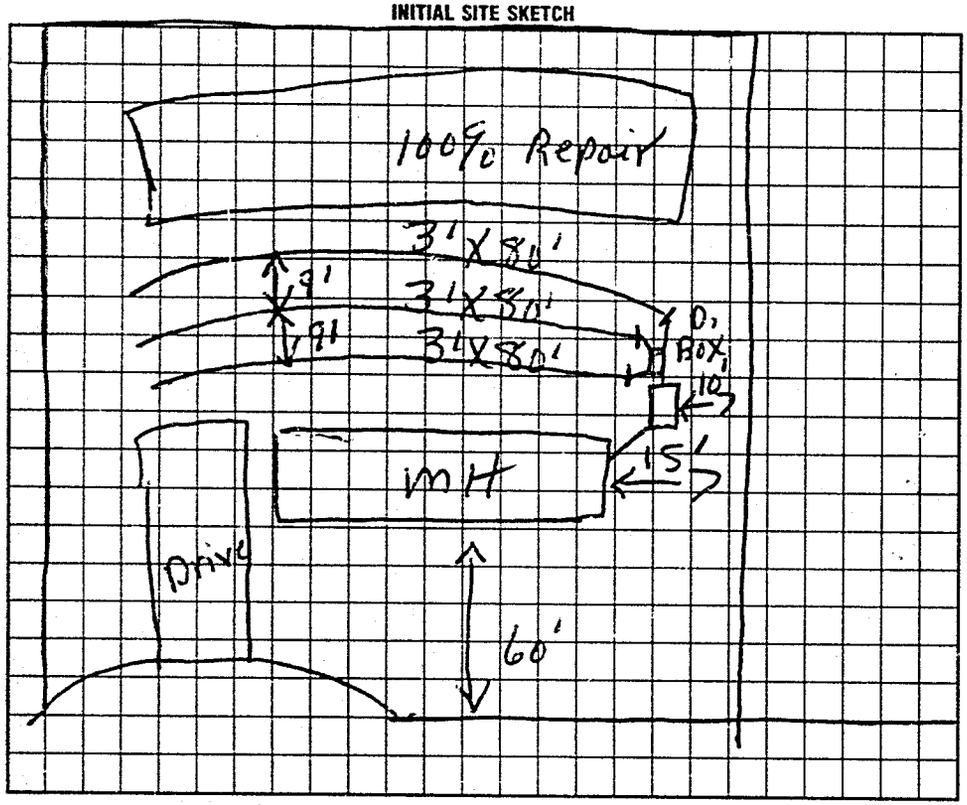

AS BUILT SKETCH

Same as initial sketch

I understand that this permit can be suspended or revoked if any false information is supplied toward securing the permit/any unauthorized changes are made to the site/any unauthorized changes are made in the installation of the system. Improvement Permit is valid for 60 months from date of issuance.

Signed: T+T Co. by J. Thabet Installed by: Donald Fochus

Improvement Permit by: L. C. Moore date 5-25-94 Certificate of Completion by: L. C. Moore date 6-7-94

Existing System Inspection by: date Operation Permit by: date

HEALTH DEPT. COPY: WHITE INSPECTION COPY (FINAL): GREEN OWNER COPY (FINAL): YELLOW INSPECTION COPY (INITIAL): PINK OWNER COPY (INITIAL): GOLD

$252.00