110 Tulip Tree Ct.

IREDELL COUNTY HEALTH DEPARTMENT

STATESVILLE 704-878-5305 MOORESVILLE 704-664-3281

IMPROVEMENT PERMIT / AUTHORIZATION TO CONSTRUCT / OPERATION PERMIT / EXISTING SYSTEM INSPECTION

PERMIT# 89039 PIN# 4763-70-7898 DATE 5/17/00

OWNER OR CONTRACTOR ISAACS FAMILY CTO PHONE: Business 878-9171 Home

ADDRESS 300 E BROAD ST. STATESVILLE NC 28677

LOCATION I-77 - IR MOREHEAD - IR WELLMAKE TL BEG FOREST - IR TULIPTREE CT R

SUBDIVISION FOREST ACRES BLOCK / SECTION II LOT 335 LOT AREA .4 ± AC SITE CLASS. PS DESIGN FLOW 240 GPD L.T.A.R. .35 gpd/ft²

Septic Tank: 1000 Gallons; STB 1012 Date 3-18-94
Pump Tank: Gallons; PT Date
Pump Make: Model Serial No.
Kleinfelter Field: No Fields 1 Square Feet 720 Linear Feet 240
No Lines 3 Trench Width 36" Max Trench Bottom Depth 36" Gravel Depth 12"

☑ New System ☐ Repair System Type: I II III IV V VI
System Description: CONVENTIONAL GRAV.
Repair System Description: SAME
Maintenance Agreement Required: ☐ Yes ☐ No

☐ House/Mod. Home No. Bedrooms 3
☑ Mobile Home No. Bathrooms 2
☐ Business No. Employees
☐ Other

☐ Slab ☑ Crawl Space ☐ Basement w/plumbing ☐ Basement w/o plumbing


Water Supply: ☐ Individual ☐ Public ☐ Community

Comments/Conditions:

Comments/Conditions: EXISINT

INITIAL SITE SKETCH

AS BUILT SKETCH NOT TO SCALE

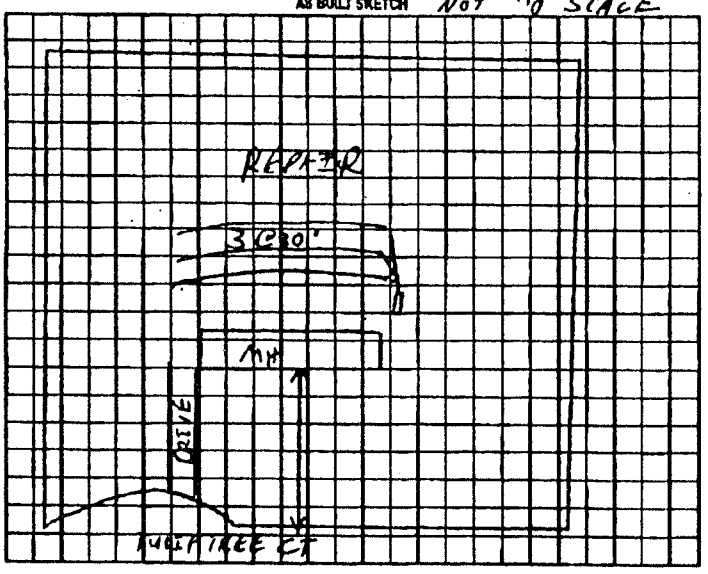

Permit can be suspended or revoked if any false information is supplied toward securing the permit/any unauthorized changes are made to the site/any unauthorized changes are made in the installation of the system. Improvement Permit with plat valid without expiration. Improvement Permit with site plan valid for sixty months. Authorization to Construct is valid for a period equal to that of Improvement Permit – not to exceed sixty months.

Signed: date

Improvement Permit by: date

Authorization to Construct by: Date

Installed by:

Operation Permit by: date

Existing System Inspection by: C. [illegible] RS Date 5/17/00