48840

IREDELL COUNTY HEALTH DEPARTMENT

STATESVILLE 704-878-5305 MOORESVILLE 704-664-5281

IMPROVEMENT PERMIT / CERTIFICATE OF COMPLETION / OPERATION PERMIT / EXISTING SYSTEM INSPECTION

PROPERTY DESCRIPTION NO. 15485 DATE 9-17-93 TAX MAP NO. 5K-7-A-249

OWNER OR CONTRACTOR T+T Inc. PHONE: Business 878 6660 Home

ADDRESS

LOCATION 70 E TR Morehead Dr. TR Well Hse Dr. TL Big Forest Dr. Yamion Rd

SUBDIVISION Forest Acres BLOCK / SECTION II LOT 249 250 251 LOT AREA 1 Acre+ SITE CLASS. 3 P5 L.T.A.R. .216

Water Supply: ☐ Individual ☐ Community ☒ Public

Septic Tank: 1000 Gallons; STB 358 Date 8-4-93

Pump Tank: Gallons; PT Date

Nitrification Field: No Fields 1 Square Feet 900 Linear Feet 300

No Lines 3 Trench Width 36 Trench Depth 18+36 Gravel Depth 12"

☒ New System ☐ Repair System Type: I II. IV. V. VI

System Description: Conv. Gravity

Repair System Description: Pump Conv.

Maintenance Agreement Required: ☐ Yes ☒ No

☐ House/Mod. Home ☒ Mobile Home ☐ Business ☐ Other

No. Bedrooms 2 No. Bathrooms 2 No. Employees

☐ Slab ☒ Crawl Space ☐ Basement w/plumbing ☐ Basement wo/plumbing

Garbage Disposal: ☐ Yes ☒ No


Auto. Dishwasher: ☐ Yes ☐ No

Auto. Washing Machine: ☐ Yes ☐ No


Other

Comments Home set Too low To Get System In Front as original designed + laid out. Had To Put System in original Repair area + Go To Pumped Repair.

INITIAL SITE SKETCH

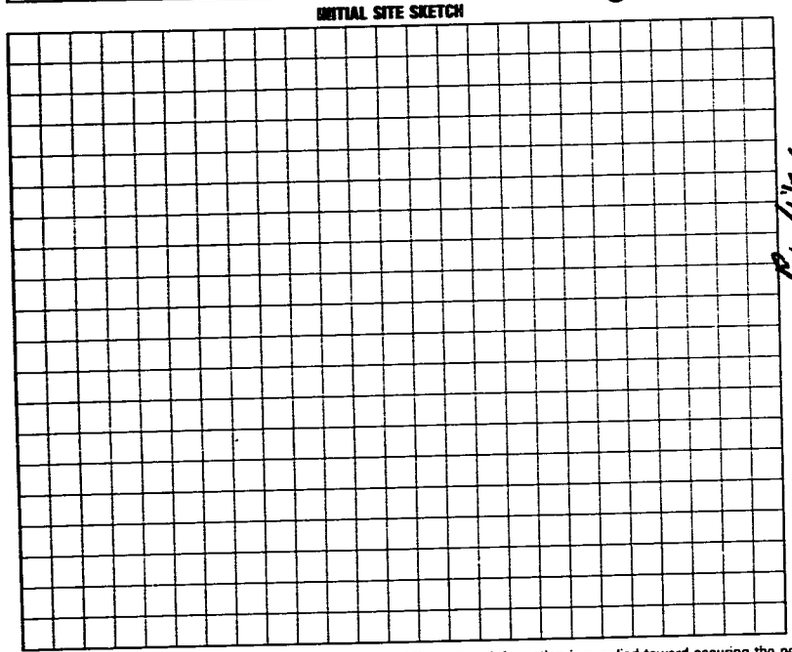

AS BUILT SKETCH

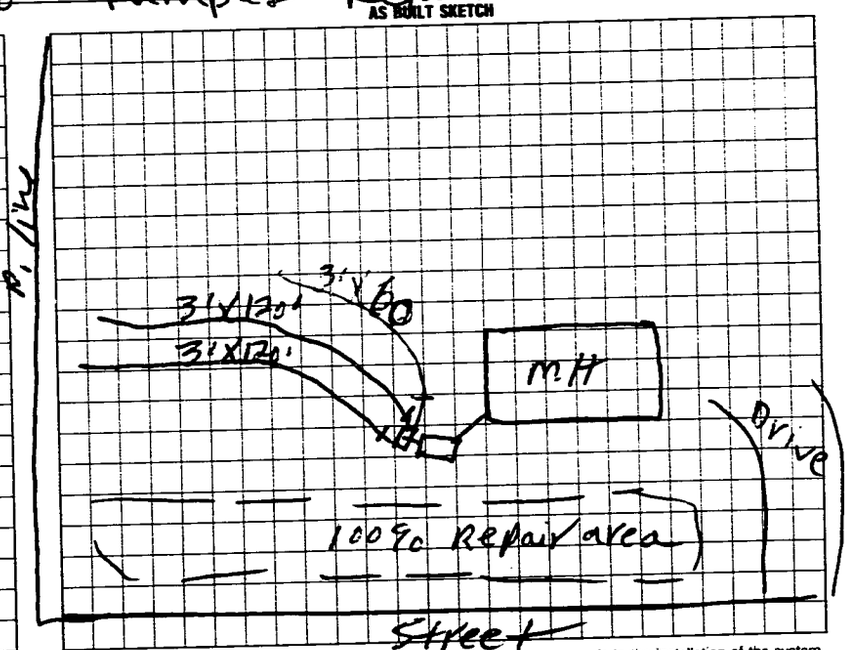

I understand that this permit can be suspended or revoked if any false information is supplied toward securing the permit/any unauthorized changes are made to the site/any unauthorized changes are made in the installation of the system. Improvement Permit is valid for 60 months from date of issuance.

Signed:

Improvement Permit by: JC Moore date 3-2-93

Existing System Inspection by: date

Installed by: Donald Fachers

Certificate of Completion by: E. C. Moore date 9-17-93

Operation Permit by: date

HEALTH DEPT. COPY: WHITE INSPECTION COPY (FINAL): GREEN OWNER COPY (FINAL). YELLOW INSPECTION COPY (INITIAL): PINK OWNER COPY (INITIAL) GOLD