49227

IREDELL COUNTY HEALTH DEPARTMENT

STATESVILLE 704-878-5305 MOORESVILLE 704-664-5281

IMPROVEMENT PERMIT / CERTIFICATE OF COMPLETION / OPERATION PERMIT / EXISTING SYSTEM INSPECTION

PROPERTY DESCRIPTION NO. 15484 DATE 10-20-93 TAX MAP NO. 5K-7-A-245 Watershed: ☐ Yes ☒ No

OWNER OR CONTRACTOR T & T Co Inc. PHONE: Business 873-6660 Home

ADDRESS Rt 15 Statesville

LOCATION US 70E TR merchant Dr. TR Oldwell Dr TR Big Forest Dr. 1/4mi on Rt.

SUBDIVISION Forest Acres BLOCK / SECTION B LOT 244 245 LOT AREA 1 1/2 acre SITE CLASS P5 DESIGN FLOW 360 L.T.A.R. .15

Septic Tank: 1000 Gallons; STB Date

Pump Tank: 1000 Gallons; PT Date

Pump Make: Model Serial No.

Nitrification Field: No Fields 1 Square Feet 2400 Linear Feet 480

No Lines 4 Trench Width 18" Max Trench Bottom Depth 18" Gravel Depth 12"

☒ New System ☐ Repair System Type: I, II, III, IV, V, VI

System Description: LPP

Repair System Description: LPP

Maintenance Agreement Required: ☒ Yes ☐ No

☐ House/Mod. Home ☐ Mobile Home ☐ Business ☐ Other

No. Bedrooms 3 No. Bathrooms 2 No. Employees


☐ Slab ☒ Crawl Space ☐ Basement w/plumbing ☐ Basement wo/plumbing

Water Supply: ☐ Individual ☐ Community ☒ Public


Comments: A maintenance Agreement must be Provided To The Iredell Co. Health Dept before The System can be Finaled

Comments: David Yountz a certified Subsurface System operator will be responsible for Inspection + maintenance

INITIAL SITE SKETCH

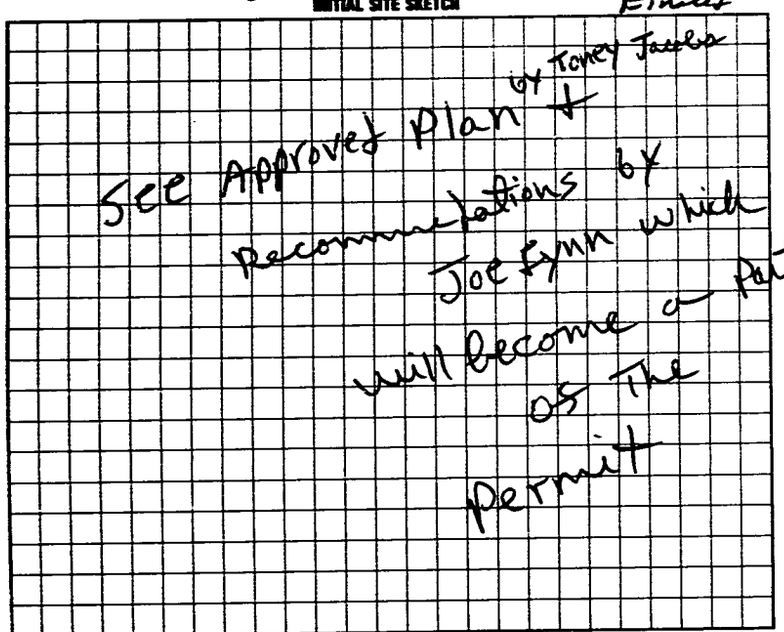

AS BUILT SKETCH

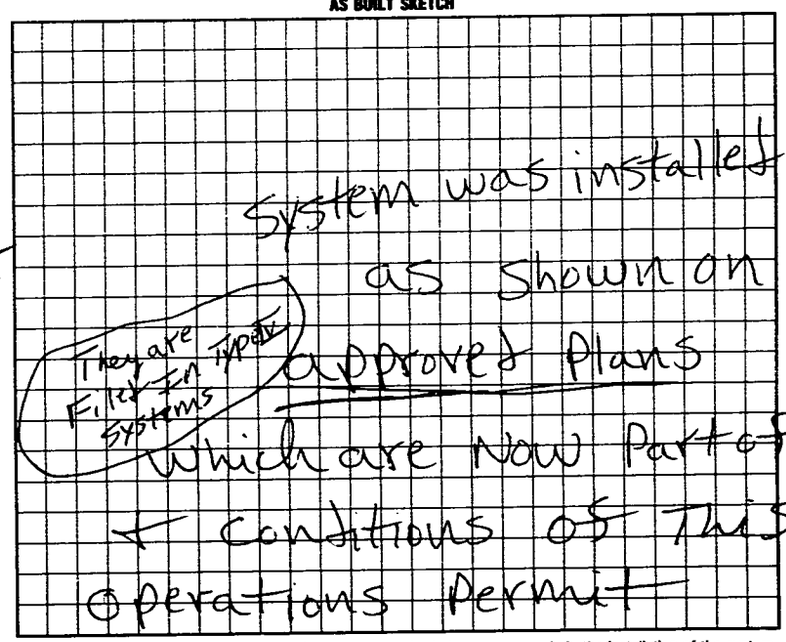

I understand that this permit can be suspended or revoked if any false information is supplied toward securing the permit/any unauthorized changes are made to the site/any unauthorized changes are made in the installation of the system. Improvement Permit is valid for 60 months from date of issuance.

Signed: T & T Co. by Harold J Thabet

Improvement Permit by: P.C. moore date 10-20-93

Existing System Inspection by: date

Installed by: David Yountz

Certificate of Completion by: date

Operation Permit by: P.C. moore date 10-29-93

HEALTH DEPT. COPY: WHITE INSPECTION COPY (FINAL): GREEN OWNER COPY (FINAL): YELLOW INSPECTION COPY (INITIAL): PINK OWNER COPY (INITIAL): GOLD