IREDELL COUNTY HEALTH DEPARTMENT

STATESVILLE 704-878-5305 MOORESVILLE 704-664-5281

IMPROVEMENT PERMIT / CERTIFICATE OF COMPLETION / OPERATION PERMIT / EXISTING SYSTEM INSPECTION

TAX MAP NO. 5J-A-72

PROPERTY DESCRIPTION NO. 15304 DATE 6-1-93 PHONE: Business 878-6660 Home

OWNER OR CONTRACTOR I+I Inc.

ADDRESS Po Box 1835 Statesville N.C. 28687

LOCATION 70E past John Long Rd TR morehead Rt on old well Hse Rd left Big Forest Vernon Rd

SUBDIVISION Forest Acres BLOCK / SECTION II LOT 247+248 LOT AREA 1acre+ SITE CLASS. D5. L.T.A.R. .13 sal/35' Hay

Water Supply: ☐ Individual ☐ Community ☒ Public

Septic Tank: 1000 Gallons; STB 782 Date 5-3-93

Pump Tank: Gallons; PT Date

Nitrification Field: No Fields 1 Square Feet 1200 Linear Feet 400

No Lines 6 Trench Width 36" Trench Depth 24" Gravel Depth 12"

☒ New System ☐ Repair System Type: I, II, III, IV, V, VI

System Description: Conv Gravity

Repair System Description: Porus Block Pressure Joset

Maintenance Agreement Required: ☐ Yes ☐ No

☐ House/Mod. Home ☒ Mobile Home ☐ Business ☐ Other

No. Bedrooms 3 No. Bathrooms 2 No. Employees

Garbage Disposal: ☐ Yes ☒ No

Auto. Dishwasher: ☐ Yes ☒ No


Auto. Washing Machine: ☒ Yes ☐ No

Other


☐ Slab ☐ Crawl Space ☐ Basement w/plumbing ☐ Basement wo/plumbing

Comments Fill In Drainage ways on both sides of lot with Debris Free Soil & Compact Repair area will require Type IV System which will require maintenance agreement

INITIAL SITE SKETCH

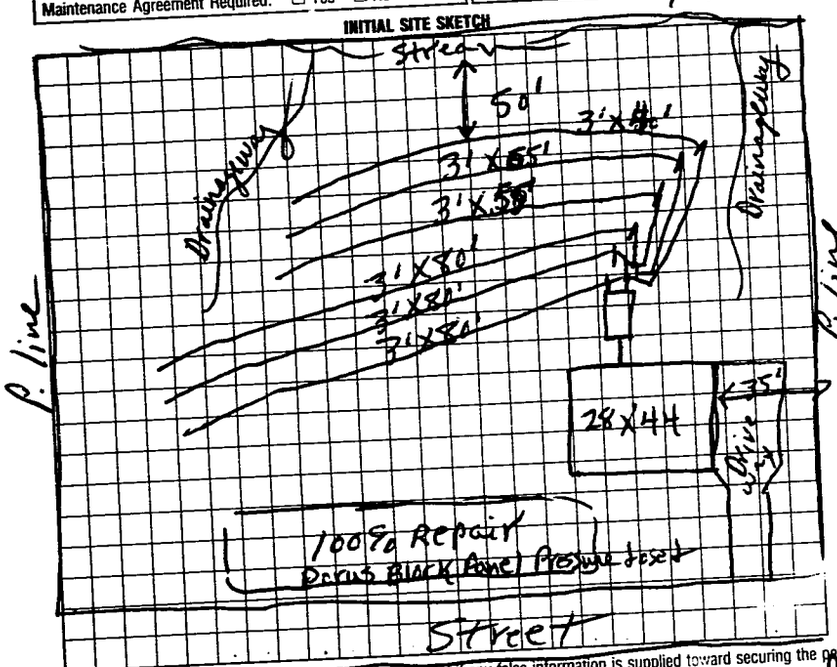

AS BUILT SKETCH

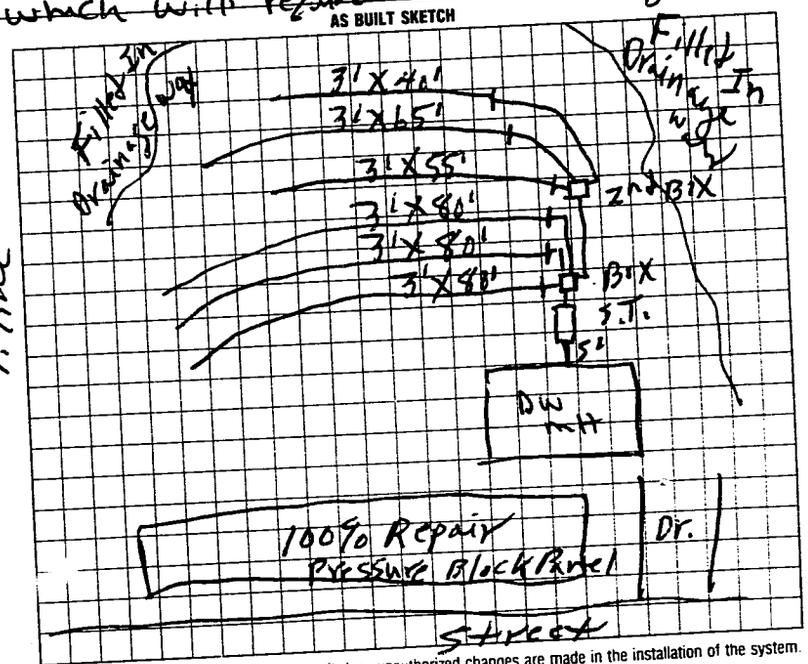

I understand that this permit can be suspended or revoked if any false information is supplied toward securing the permit/any unauthorized changes are made to the site/any unauthorized changes are made in the installation of the system. Improvement Permit is valid for 60 months from date of issuance.

Signed: P. C. moore I+I Co, H+T Asst date

Improvement Permit by: date

Existing System Inspection by:

Installed by: Donald Tackett

Certificate of Completion by: P. C. moore date 7-20-93

Operation Permit by: date

HEALTH DEPT. COPY: WHITE INSPECTION COPY (FINAL): GREEN OWNER COPY (FINAL): YELLOW INSPECTION COPY (INITIAL): PINK OWNER COPY (INITIAL): GOLD