IREDELL COUNTY HEALTH DEPARTMENT

STATESVILLE 704-878-5305 MOORESVILLE 704-664-5281

IMPROVEMENT PERMIT / CERTIFICATE OF COMPLETION / OPERATION PERMIT / EXISTING SYSTEM INSPECTION

PROPERTY DESCRIPTION NO. 17336 DATE 10-26-93 TAX MAP NO. SK-7-A-214 Watershed: ☐ Yes ☒ No

OWNER OR CONTRACTOR H T T Co Inc PHONE: Business 878 6660 Home

ADDRESS PO Box 288 Statesville

LOCATION 70E TR Mooresville TR old well Dr Big Fourk Dr. 1/4mi on left

SUBDIVISION Forest Acres BLOCK / SECTION I LOT 214 LOT AREA approx 1/4acre SITE CLASS. PS DESIGN FLOW - L.T.A.R.

Septic Tank: 1000 Gallons; STB 1017 Date 8-17-93

Pump Tank: Gallons; PT Date

Pump Make: Model Serial No.

Nitrification Field: No Fields 1 Square Feet 1035 Linear Feet 345

No Lines 4 Trench Width 36 Max Trench Bottom Depth 36

☒ New System ☐ Repair System Type: I, ☒ II, III, IV, V, VI

System Description: conv. Gravity

Repair System Description: Perus Block Panel

Maintenance Agreement Required: ☐ Yes ☒ No

☐ House/Mod. Home ☒ Mobile Home ☐ Business ☐ Other

No. Bedrooms 3 No. Bathrooms 2 No. Employees

☐ Slab ☒ Crawl Space ☐ Basement w/plumbing ☐ Basement wo/plumbing


Gravel Depth 12"

Water Supply: ☐ Individual ☐ Community ☒ Public


Comments: House To be set back approx. 90 to 100' off Road Fill In erosion Drainage way

Comments: installed 355' Drain line

INITIAL SITE SKETCH

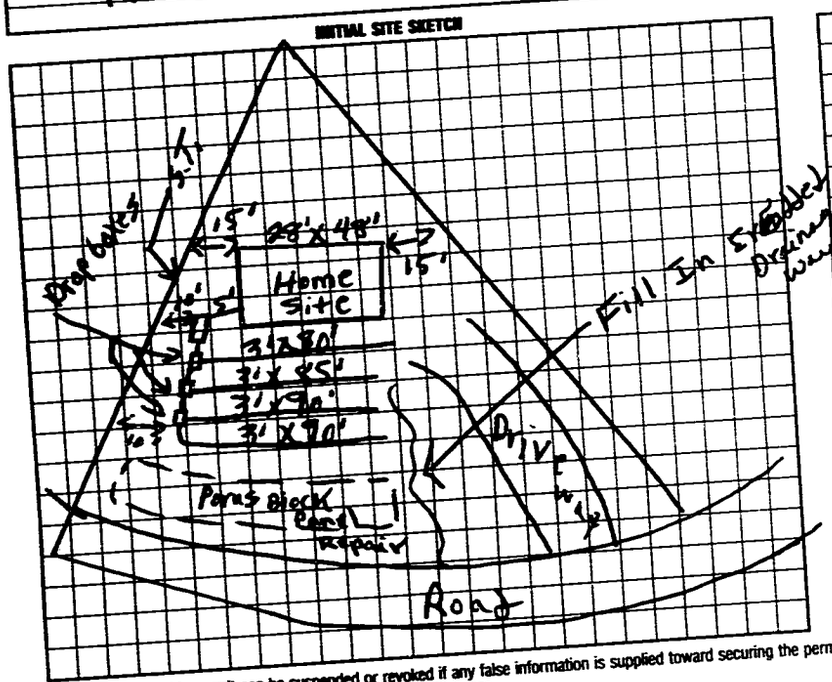

AS BUILT SKETCH

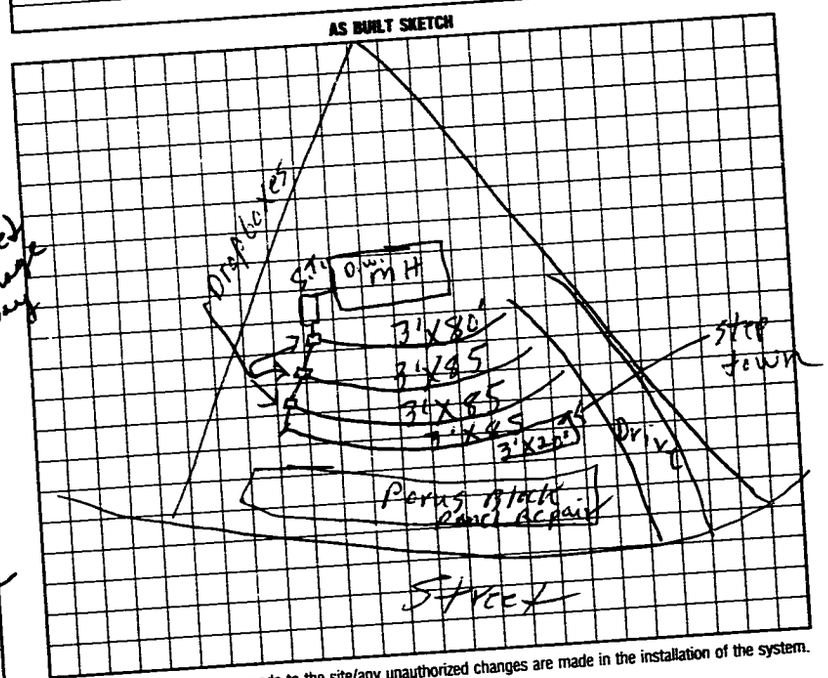

I understand that this permit can be suspended or revoked if any false information is supplied toward securing the permit/any unauthorized changes are made to the site/any unauthorized changes are made in the installation of the system. Improvement Permit is valid for 60 months from date of issuance.

Signed: H T T Co, H.J. Hunter as agent for Buyer

Improvement Permit by: R. C. moore date 10-26-93

Existing System Inspection by: date

Installed by: Donald Lackey

Certificate of Completion by: R. C. moore date 11-24-93

Operation Permit by: date

HEALTH DEPT. COPY: WHITE INSPECTION COPY (FINAL): GREEN OWNER COPY (FINAL): YELLOW INSPECTION COPY (INITIAL): PINK OWNER COPY (INITIAL): GOLD