IREDELL COUNTY HEALTH DEPARTMENT

STATESVILLE 704-878-5305 MOORESVILLE 704-664-5281

IMPROVEMENT PERMIT / CERTIFICATE OF COMPLETION / OPERATION PERMIT / EXISTING SYSTEM INSPECTION

PROPERTY DESCRIPTION NO. 14631 DATE 6-2-94 TAX MAP NO. 5H-N-A-211 Watershed: ☐ Yes ☑ No

OWNER OR CONTRACTOR T+T Inc. PHONE: Business 878 6660 Home

ADDRESS PO BOX 238 Sta

LOCATION 705 TR morehead TR old well Dr. TL Big Foot 1/2 mi on left

SUBDIVISION Forest Acres BLOCK / SECTION IV LOT 211+212 LOT AREA approx large SITE CLASS. PS DESIGN FLOW 360 L.T.A.R. 1.33

Septic Tank: 1000 Gallons; STB 1012 Date 6-13-94
Pump Tank: Gallons; PT Date
Pump Make: Model Serial No.
Nitrification Field: No Fields 1 Square Feet 1050 Linear Feet 350
No Lines 5 Trench Width 36" Max Trench Bottom Depth 36" Gravel Depth 12"

☑ New System ☐ Repair System Type: I, ☑ II, III, IV, V, VI
System Description: Conv. Gravity
Repair System Description: Perma Block Panel
Maintenance Agreement Required: ☐ Yes ☑ No

☑ House/Mod. Home No. Bedrooms 3
☐ Mobile Home No. Bathrooms 2
☐ Business No. Employees
☐ Other

☐ Slab ☑ Crawl Space ☐ Basement w/plumbing ☐ Basement wo/plumbing


Water Supply:
☐ Individual
☐ Community
☑ Public

Comments:


Lot 211 Lot 212

Comments:

INITIAL SITE SKETCH

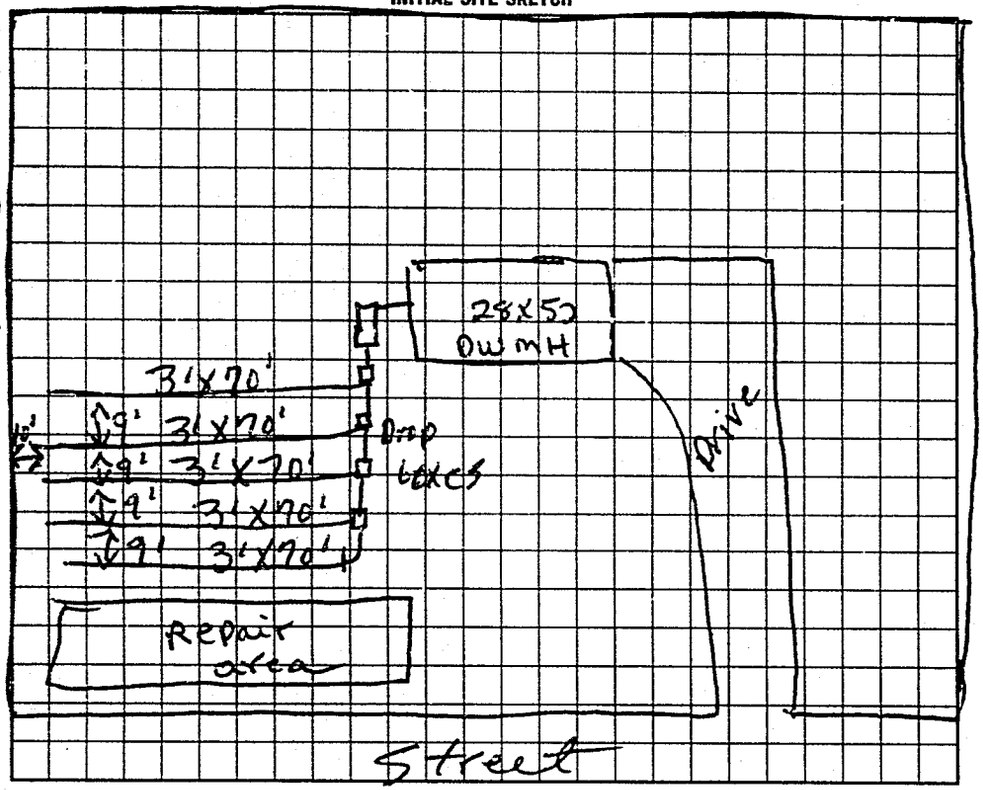

AS BUILT SKETCH

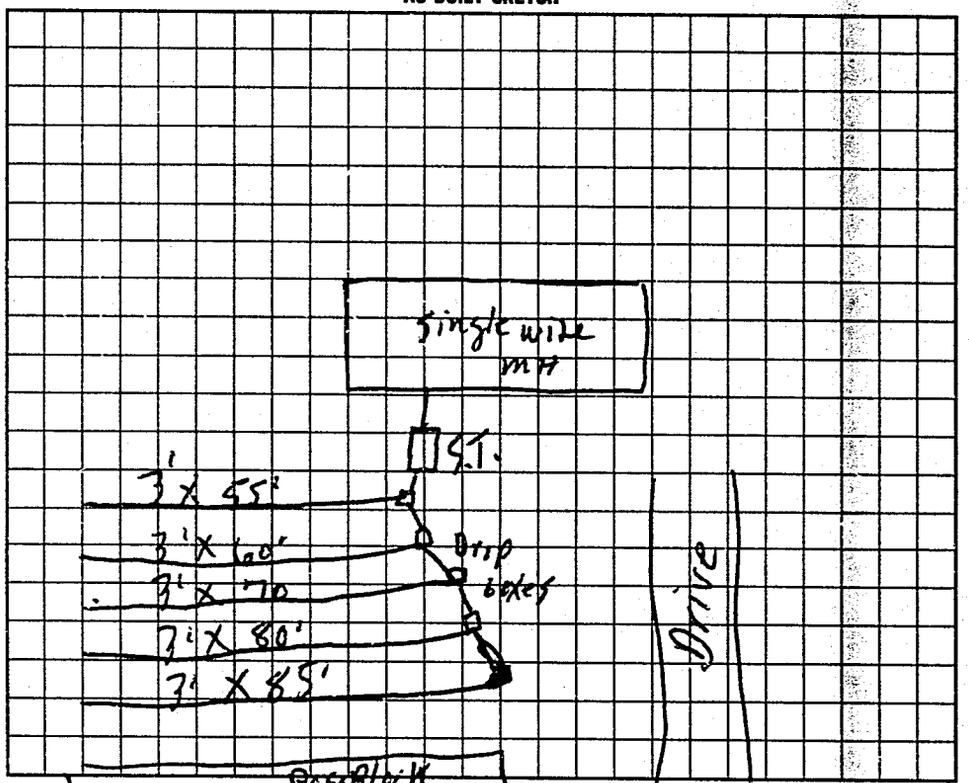

I understand that this permit can be suspended or revoked if any false information is supplied toward securing the permit/any unauthorized changes are made to the site/any unauthorized changes are made in the installation of the system. Improvement Permit is valid for 60 months from date of issuance.

Signed: W. J. Thabet

Improvement Permit by: P. C. moore date 6-2-94

Existing System Inspection by: date

Installed by: Donald Tacky

Certificate of Completion by: P. C. moore date 6-2-94

Operation Permit by: date

HEALTH DEPT. COPY: WHITE INSPECTION COPY (FINAL): GREEN OWNER COPY (FINAL): YELLOW INSPECTION COPY (INITIAL): PINK OWNER COPY (INITIAL): GOLD