IREDELL COUNTY HEALTH DEPARTMENT

STATESVILLE 704-878-5305 MOORESVILLE 704-664-5281

IMPROVEMENT PERMIT / CERTIFICATE OF COMPLETION / OPERATION PERMIT / EXISTING SYSTEM INSPECTION

PROPERTY DESCRIPTION NO. 19818 DATE 7-25-96 TAX MAP NO. 5k-7-A-210 Watershed: ☐ Yes ☒ No

OWNER OR CONTRACTOR T+T Co PHONE: Business _____ Home 878-6660

ADDRESS PO Box 1835 Statesville NC

LOCATION 70E, TR Maplehead, TR OH Well House Rd, TL Big Forest Rd lot on left

SUBDIVISION Forest Acres BLOCK / SECTION 1 LOT 210 LOT AREA _____ SITE CLASS. P/S DESIGN FLOW 360 L.T.A.R. 0.3

Septic Tank: 1000 Gallons; STB 1012 Date 3-4-97

Pump Tank: _____ Gallons; PT _____ Date _____

Pump Make: _____ Model _____ Serial No. _____

Nitrification Field: No Fields 1 Square Feet 1200 Linear Feet 400

No Lines 5 Trench Width 36" Max Trench Bottom Depth 36" Gravel Depth 12

☒ New System ☐ Repair System Type: I, II, III, IV, V, VI

System Description: Conventional/Gravity

Repair System Description: Conventional/Gravity

Maintenance Agreement Required: ☐ Yes ☒ No

☐ House/Mod. Home No. Bedrooms 3

☒ Mobile Home No. Bathrooms 2

☐ Business No. Employees ____

☐ Other _____


☐ Slab ☒ Crawl Space ☐ Basement w/plumbing ☐ Basement wo/plumbing

Water Supply: ☐ Individual ☐ Community ☒ Public


Comments:

Comments:

INITIAL SITE SKETCH

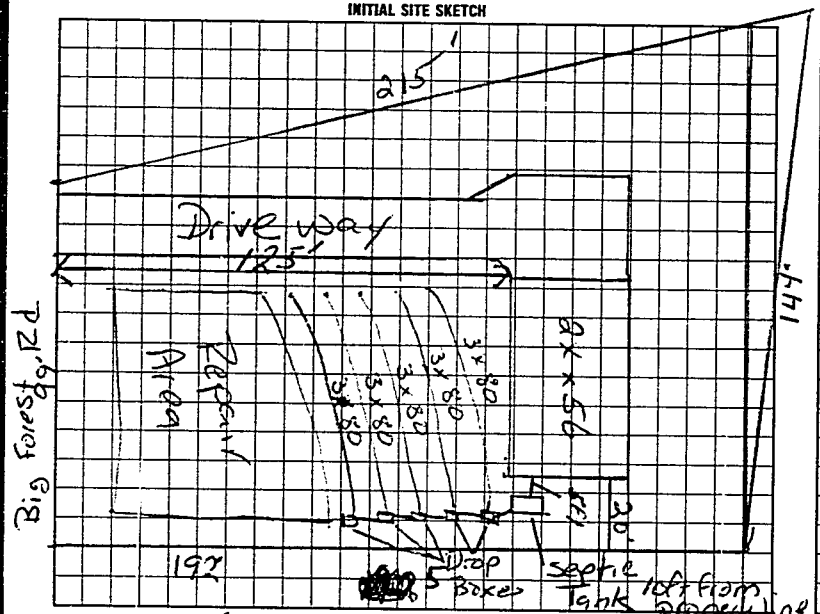

AS BUILT SKETCH

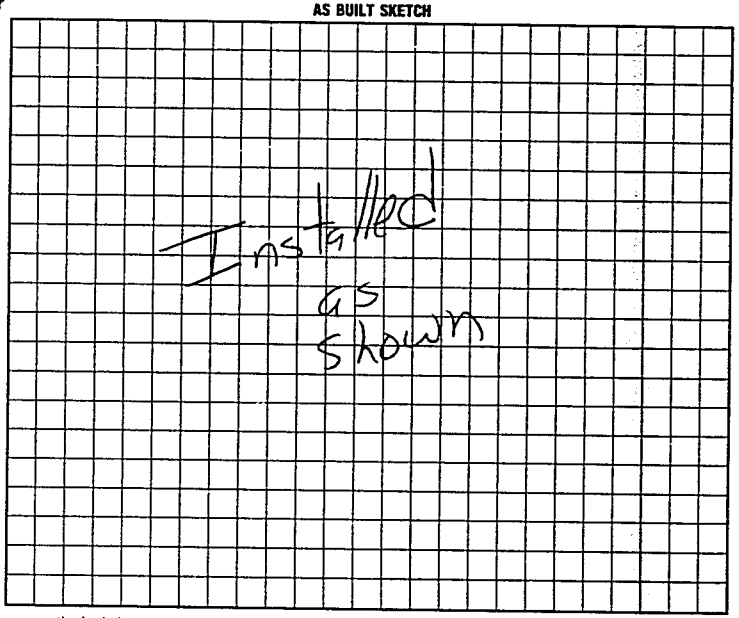

I understand that this permit can be suspended or revoked if any false information is supplied toward securing the permit/any unauthorized changes are made to the site/any unauthorized changes are made in the installation of the system.

Signed: X Arthur C. Riddle for T+T Co

Improvement Permit by: F.C. Moore date 7-24-96

Authorization to Construct/existing system inspection by: F.C. Moore date 7-24-96

Installed by: Donald Lackey

Certificate of Completion by: _____ date _____

Operation Permit by: Mark C Owens date 5-12-97

Authorization to Const. Expires 60 months from date of issue

HEALTH DEPT. COPY: WHITE INSPECTION COPY (FINAL): GREEN OWNER COPY (FINAL): YELLOW INSPECTION COPY (INITIAL): PINK OWNER COPY (INITIAL): GOLD