IREDELL COUNTY HEALTH DEPARTMENT

STATESVILLE 704-878-5305 MOORESVILLE 704-664-5281

IMPROVEMENT PERMIT / CERTIFICATE OF COMPLETION / OPERATION PERMIT / EXISTING SYSTEM INSPECTION

PROPERTY DESCRIPTION NO. 15529 DATE 1-19-94 TAX MAP NO. 5K-7-A-20M Watershed: ☐ Yes ☐ No

OWNER OR CONTRACTOR T+T Ents Inc PHONE: Business 8788660 Home

ADDRESS PO Box 5ta

LOCATION 70E TR Moresville TR well Hse Or, TL Bigfoot TL Bayberry Ct 1st lft rt

SUBDIVISION Forest Acres BLOCK / SECTION IV LOT 207 LOT AREA .688 acres SITE CLASS. PS DESIGN FLOW 360 L.T.A.R. .34

Septic Tank: 1000 Gallons; STB 358 Date 11-30-93

Pump Tank: Gallons; PT Date

Pump Make: Model Serial No.

Nitrification Field: No Fields 1 Square Feet 1150 Linear Feet 350

No Lines 3 Trench Width 36 Max Trench Bottom Depth 24 Gravel Depth 12

☑ New System ☐ Repair System Type: I, II, III, IV, V, VI

System Description: Conv. Gravity

Repair System Description: Conv. Gravity

Maintenance Agreement Required: ☐ Yes ☐ No

☐ House/Mcd. Home ☑ Mobile Home ☐ Business ☐ Other

No. Bedrooms 3 No. Bathrooms 2 No. Employees


☐ Slab ☑ Crawl Space ☐ Basement w/plumbing ☐ Basement wo/plumbing

Water Supply: ☐ Individual ☐ Community ☑ Public

Comments:

Comments:

INITIAL SITE SKETCH

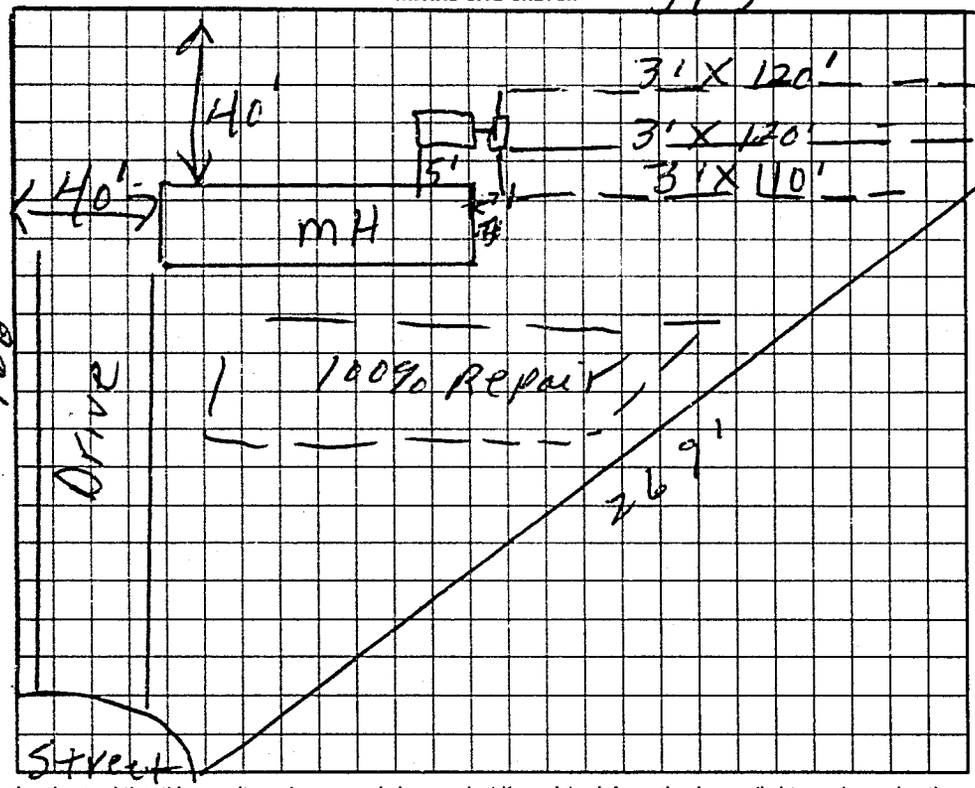

AS BUILT SKETCH

Same as initial sketch

I understand that this permit can be suspended or revoked if any false information is supplied toward securing the permit/any unauthorized changes are made to the site/any unauthorized changes are made in the installation of the system. Improvement Permit is valid for 60 months from date of issuance.

Signed: T+T Co by Harold G Thalist

Improvement Permit by: L. C. Moore date 1-19-94

Existing System Inspection by: date

Installed by: Donald Lackey

Certificate of Completion by: L. C. Moore date 2-18-94

Operation Permit by: date

HEALTH DEPT. COPY: WHITE INSPECTION COPY (FINAL): GREEN OWNER COPY (FINAL): YELLOW INSPECTION COPY (INITIAL): PINK OWNER COPY (INITIAL): GOLD