IREDELL COUNTY HEALTH DEPARTMENT

STATESVILLE 704-878-5305 MOORESVILLE 704-664-5281 (c1)

IMPROVEMENT PERMIT / AUTHORIZATION TO CONSTRUCT / OPERATION PERMIT / EXISTING SYSTEM INSPECTION

PERMIT# 119293 PIN# 4763-71-5916 DATE 3-22-03

OWNER OR CONTRACTOR FENN CLARK PHONE: Business 704-838-1429 Home

ADDRESS 590 MOCKSVILLE Hwy STATESVILLE, NC 28625

LOCATION US 70 EAST, TR MOREHEAD DR, TR OLD WELLHOUSE DR, TL BIG FOREST DR, TL BAY BERRY CT, AT END ON RIGHT

SUBDIVISION FOREST ACRES BLOCK / SECTION V LOT 207 LOT AREA 0.69 ACRE SITE CLASS. PS DESIGN FLOW 360 L.T.A.R. EXISTING 0.34 GPD/FT

Septic Tank: 1000 Gallons; STB 358 Date

Pump Tank: Gallons; PT Date

Pump Make: Model Serial No.

Nitrification Field: No Fields 1 Square Feet 1050 Linear Feet 350

No Lines THREE Trench Width 36" Max Trench Bottom Depth >36" Gravel Depth 12"

☐ New System ☐ Repair System Type: I, II, III, IV, V, VI

System Description: CONVENTIONAL, GRAVITY

Repair System Description: CONVENTIONAL, GRAVITY

Maintenance Agreement Required: ☐ Yes ☒ No

☐ House/Mod. Home ☒ Mobile Home ☐ Business ☐ Other

No. Bedrooms 3 No. Bathrooms 2 No. Employees


☐ Slab ☐ Crawl Space ☐ Basement w/plumbing ☐ Basement wo/plumbing

Water Supply: ☐ Individual ☒ Public ☐ Community

Comments:/Conditions:

Comments:/Conditions: KEEP BUILDING FOUNDATION MINIMUM FIVE (5) FEET FROM SEPTIC SYSTEM

INITIAL SITE SKETCH

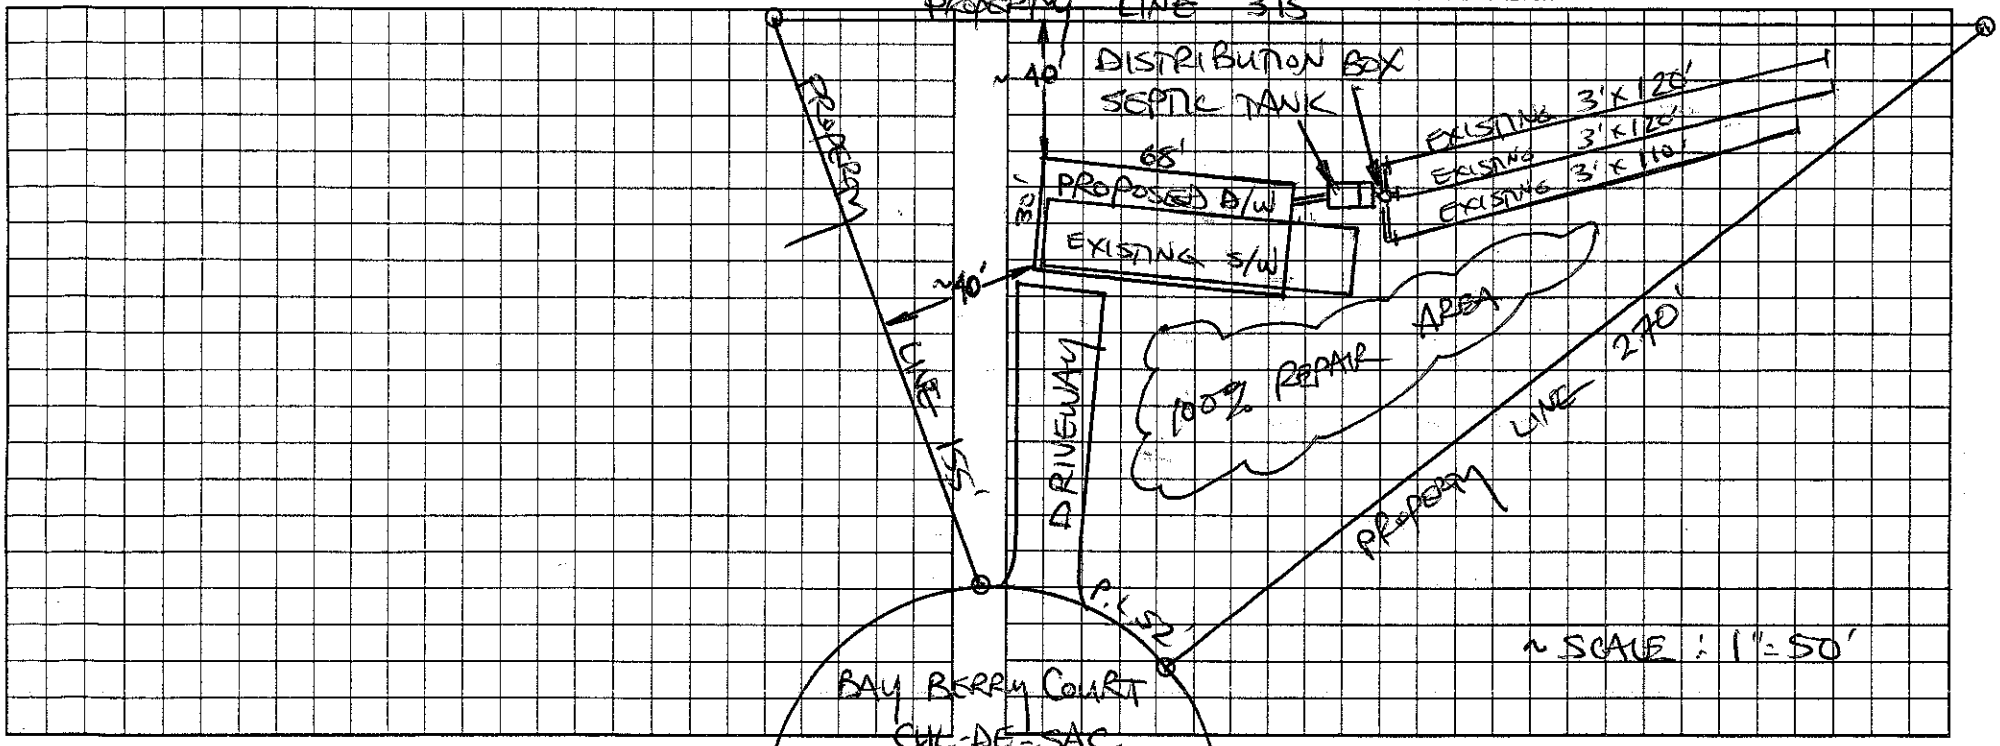

AS BUILT SKETCH

Permit can be suspended or revoked if any false information is supplied toward securing the permit/any unauthorized changes are made to the site/any unauthorized changes are made in the installation of the system. Improvement Permit with plat valid without expiration. Improvement Permit with site plan valid for sixty months. Authorization to Construct is valid for a period equal to that of Improvement Permit – not to exceed sixty months.

Signed: date Installed by:

Improvement Permit by: date Operation Permit by: date

Authorization to Construct by: date Existing System Inspection by: STEVE HENDRICK date 3-22-04

HEALTH DEPT. COPY: WHITE OWNER COPY (FINAL): YELLOW OWNER COPY (INITIAL): PINK