9:30

IREDELL COUNTY HEALTH DEPARTMENT

STATESVILLE 704-878-5305 MOORESVILLE 704-664-5281

IMPROVEMENT PERMIT / CERTIFICATE OF COMPLETION / OPERATION PERMIT / EXISTING SYSTEM INSPECTION

TAX MAP NO. 5K-7-A-216

PROPERTY DESCRIPTION NO. 16747 DATE 8-2-93 PHONE: Business 878 6660 Home

OWNER OR CONTRACTOR T+T Inc.

ADDRESS

LOCATION 70 E TR Morehead Rd at end TR offNCSR Thenat Stopsign TL BigForest Dr. 1/4mi on Left

SUBDIVISION Forest Acres BLOCK / SECTION II LOT 216 LOT AREA 180'X110 SITE CLASS. PS L.T.A.R. .33

Water Supply: ☐ Individual ☐ Community ☑ Public

Septic Tank: 1000 Gallons: STB 1212 Date 5-30-93

Pump Tank: Gallons: PT Date

Nitrification Field: No. Fields 1 Square Feet 720 Linear Feet 240

No. Lines 4 Trench Width 36 Trench Depth 18&36 Gravel Depth 12

☑ New System ☐ Repair System Type: I, II, III, IV, V, VI

System Description: Conv. Gravity

Repair System Description: LL Pump

Maintenance Agreement Required: ☐ Yes ☑ No

☐ House/Mod. Home ☐ Mobile Home ☐ Business ☐ Other

No. Bedrooms 2 No. Bathrooms 2 No. Employees

Garbage Disposal: ☐ Yes ☑ No

Auto. Dishwasher: ☐ Yes ☑ No


Auto. Washing Machine: ☑ Yes ☐ No

Other


☐ Slab ☑ Crawl Space ☐ Basement w/plumbing ☐ Basement wo/plumbing

Comments

INITIAL SITE SKETCH

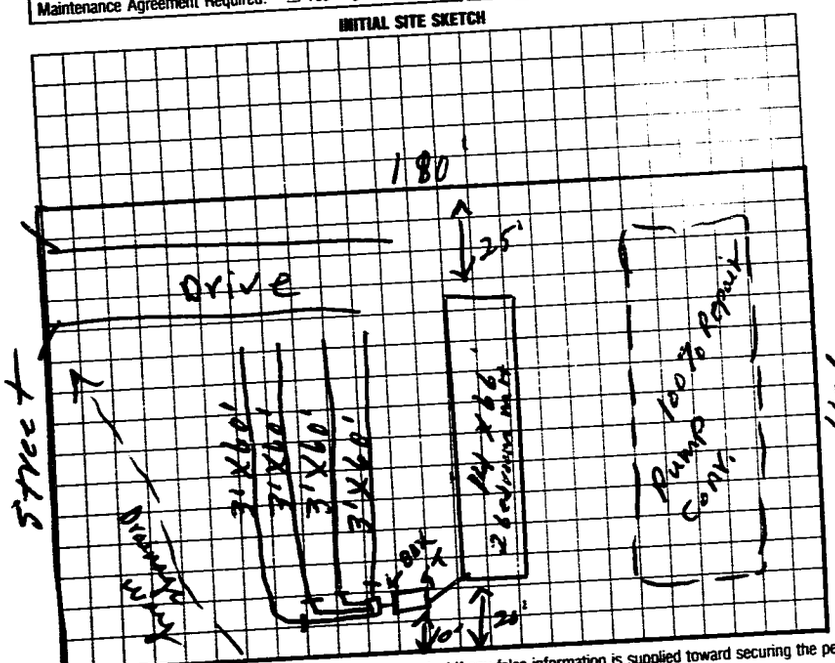

AS BUILT SKETCH

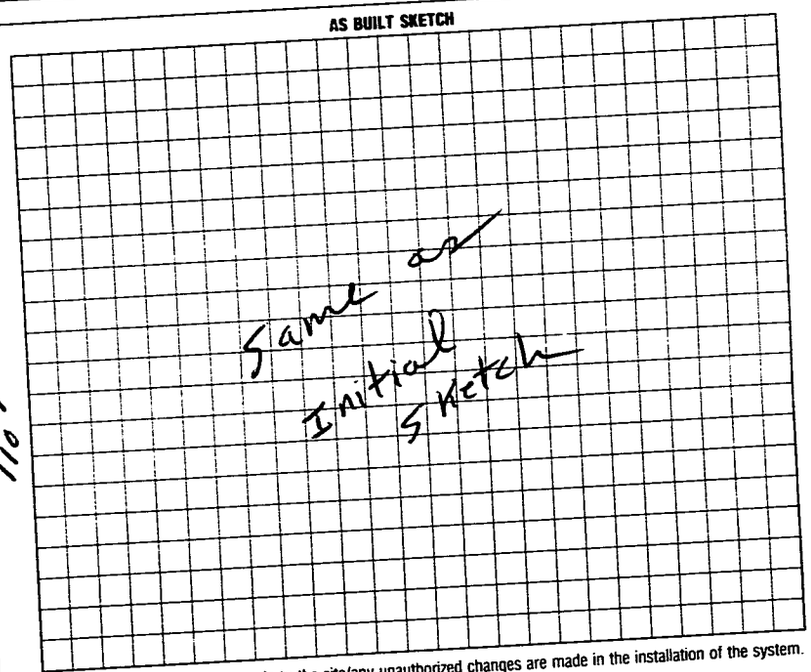

I understand that this permit can be suspended or revoked if any false information is supplied toward securing the permit/any unauthorized changes are made to the site/any unauthorized changes are made in the installation of the system. Improvement Permit is valid for 60 months from date of issuance.

Signed: J.J. Thabet for T+T Co. Installed by: Donald Tackett date 8-5-93

Improvement Permit by: J.C. moore date 8-2-93 Certificate of Completion by: J.C. moore date

Existing System Inspection by: Operation Permit by: date

HEALTH DEPT. COPY: WHITE INSPECTION COPY (FINAL): GREEN OWNER COPY (FINAL): YELLOW INSPECTION COPY (INITIAL): PINK OWNER COPY (INITIAL): GOLD