# IREDELL COUNTY HEALTH DEPARTMENT

STATESVILLE 704-878-5305 MOORESVILLE 704-664-5281

## IMPROVEMENT PERMIT / CERTIFICATE OF COMPLETION / OPERATION PERMIT / EXISTING SYSTEM INSPECTION

PROPERTY DESCRIPTION NO. 19178 DATE 7-12-94 TAX MAP NO. 5K-7-A-218 Watershed: ☐ Yes ☑ No

OWNER OR CONTRACTOR TFT Co. Inc. PHONE: Business 878 6660 Home

ADDRESS PO Box 288 sta

LOCATION 70E TR morehead TR oldwell Dr. TL Big Foot 1/2mi on L-ft

SUBDIVISION Forest Acres BLOCK / SECTION V LOT 218 LOT AREA 100'x180' SITE CLASS. OPS DESIGN FLOW 360 L.T.A.R. 1.35

Septic Tank: 1000 Gallons; STB 1012 Date 5-10-94

Pump Tank: Gallons; PT Date

Pump Make: Model Serial No.

Nitrification Field: No Fields 1 Square Feet 1035 Linear Feet 345

No Lines 4 Trench Width 36" Max Trench Bottom Depth 36" Gravel Depth 12"

☐ New System ☐ Repair System Type: I, II, III, IV, V, VI

System Description: conv. trench

Repair System Description: Forus Black Panel Gravity

Maintenance Agreement Required: ☐ Yes ☐ No

☐ House/Mod. Home No. Bedrooms 3

☐ Mobile Home No. Bathrooms 2

☐ Business No. Employees

☐ Other


☐ Slab ☑ Crawl Space ☐ Basement w/plumbing ☐ Basement wo/plumbing

Water Supply: ☐ Individual ☐ Community ☑ Public


Comments:

Comments: Home located at time of inspection. System not installed as permitted, contractor could not get 88' lines in and stay distances from boundaries. Keep water line 10' from any part of system.

INITIAL SITE SKETCH

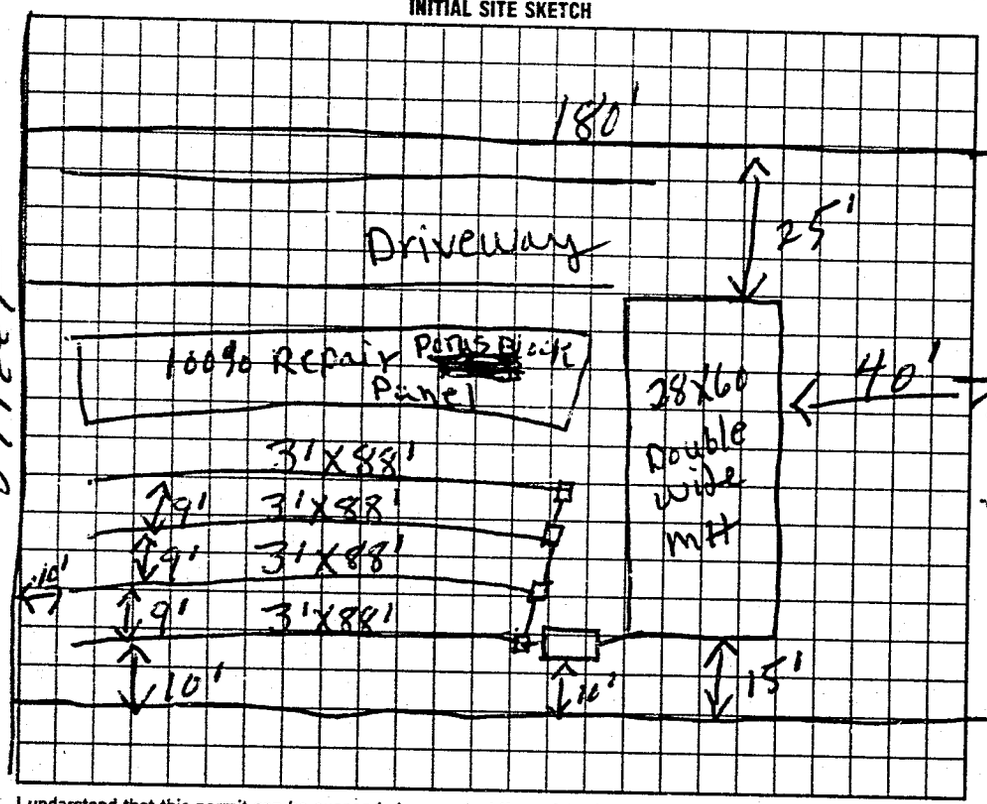


AS BUILT SKETCH

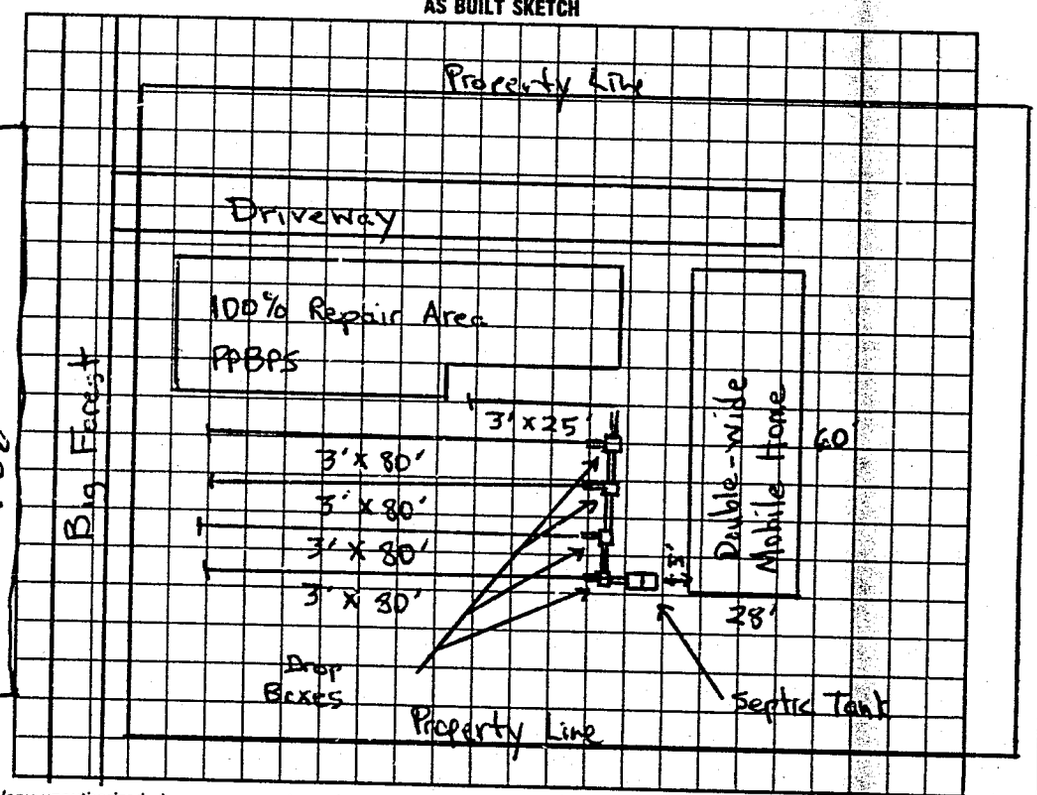


I understand that this permit can be suspended or revoked if any false information is supplied toward securing the permit/any unauthorized changes are made to the site/any unauthorized changes are made in the installation of the system. Improvement Permit is valid for 60 months from date of issuance.

Signed: TFT Co. Inc by [illegible]

Improvement Permit by: E. C. Moore date 7-11-94

Existing System Inspection by: date

Installed by: Donald Lackey

Certificate of Completion by: Michael J. Dennis date 8-12-94

Operation Permit by: date

HEALTH DEPT. COPY: WHITE INSPECTION COPY (FINAL): GREEN OWNER COPY (FINAL): YELLOW INSPECTION COPY (INITIAL): PINK OWNER COPY (INITIAL): GOLD