IREDELL COUNTY HEALTH DEPARTMENT

STATESVILLE 704-878-5305 MOORESVILLE 704-664-5281

IMPROVEMENT PERMIT / CERTIFICATE OF COMPLETION / OPERATION PERMIT / EXISTING SYSTEM INSPECTION

PROPERTY DESCRIPTION NO. 23023 DATE 1-24-96 TAX MAP NO 5K-7-A-201 Watershed Yes ✓ No

OWNER OR CONTRACTOR Tim Greer PHONE Business Home 878-0527

ADDRESS 169 Big Forest Dr.

LOCATION NOE TR Morehead TR oldwell Dr. TL Big Forest 3rd lot left

SUBDIVISION Forestacres BLOCK / SECTION II LOT 201 LOT AREA 110'X180' SITE CLASS DESIGN FLOW 360 LTAR .34

Septic Tank: 1000 Gallons; STB Date 1992
Pump Tank: Gallons; PT Date
Pump Make: Model Serial No
Nitrification Field: No Fields 1 Square Feet 1080 Linear Feet 360
No Lines 4 Trench Width 36" Max Trench Bottom Depth 36" Gravel Depth 12"

New System Repair System Type CONVENTIONAL
System Description
Repair System Description
Maintenance Agreement Required Yes No ✓
Slab Crawl Space Basement w/plumbing Basement wo/plumbing

House/Mod Home No Bedrooms 3
✓ Mobile Home No Bathrooms 2
Business No Employees
Other


Water Supply
Individual
Community
✓ Public

Comments:

Comments
new mobile Home must be Placed 5' from any part of ex. ST. System

INITIAL SITE SKETCH

AS BUILT SKETCH

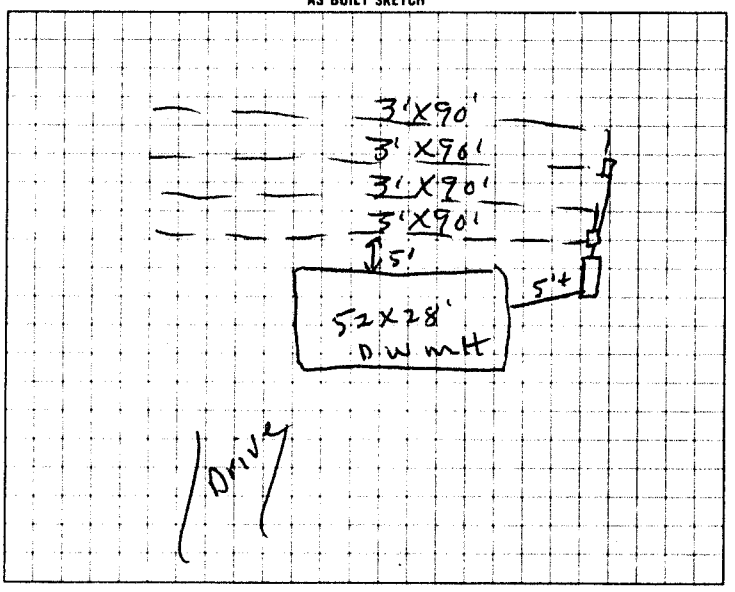

I understand that this permit can be suspended or revoked if any false information is supplied toward securing the permit any unauthorized changes are made to the site/any unauthorized changes are made in the installation of the system

Signed Installed by

Improvement Permit by date Certificate of Completion by date

Existing System Inspection by R. C. Moore date 1-24-96 Operation Permit by date

HEALTH DEPT COPY WHITE INSPECTION COPY (FINAL) GREEN OWNER COPY (FINAL) YELLOW INSPECTION COPY (INITIAL) PINK OWNER COPY (INITIAL) GOLD