IREDELL COUNTY HEALTH DEPARTMENT

STATESVILLE 704-878-5305 375.00 Paid MOORESVILLE 704-664-5281

IMPROVEMENT PERMIT / AUTHORIZATION TO CONSTRUCT / OPERATION PERMIT / EXISTING SYSTEM INSPECTION

PERMIT# 118576 PIN# 4763-74-4121 DATE 8/12/04

OWNER OR CONTRACTOR PURINA MILLS PHONE: Business Home

ADDRESS 173 McNESS RD. STATESVILLE N. 28677

LOCATION 70 EAST - BEFORE MORTHEAD RD

SUBDIVISION BLOCK / SECTION LOT LOT AREA 20.74AC SITE CLASS. PS DESIGN FLOW 1250 L.T.A.R. .36PD/ET2

Septic Tank: EXISTING-1500 Gallons; STB Date

Pump Tank: " 1500 Gallons; PT Date

Pump Make: GOULDS Model WE20J2H Serial No. AP5758558

Nitrification Field: No Fields 1 Square Feet 4200 Linear Feet 1400

No Lines 14 Trench Width 36" Max Trench Bottom Depth 36" Gravel Depth 12"

☐ New System ☐ Repair System Type: I, II, III, IV, V, VI

System Description: PUMP CONVENTIONAL

Repair System Description:

Maintenance Agreement Required: ☐ Yes ☐ No

☐ House/Mod. Home No. Bedrooms

☐ Mobile Home No. Bathrooms

☑ Business No. Employees 50

☐ Other PURINA PROCESSING


☐ Slab ☐ Crawl Space ☐ Basement w/plumbing ☐ Basement wo/plumbing

Water Supply: ☐ Individual ☑ Public ☐ Community


Comments:/Conditions: FOR DOMESTIC WASTE ONLY. NO INDUSTRIAL WASTE.

Comments:/Conditions: DOMESTIC ONLY

INITIAL SITE SKETCH

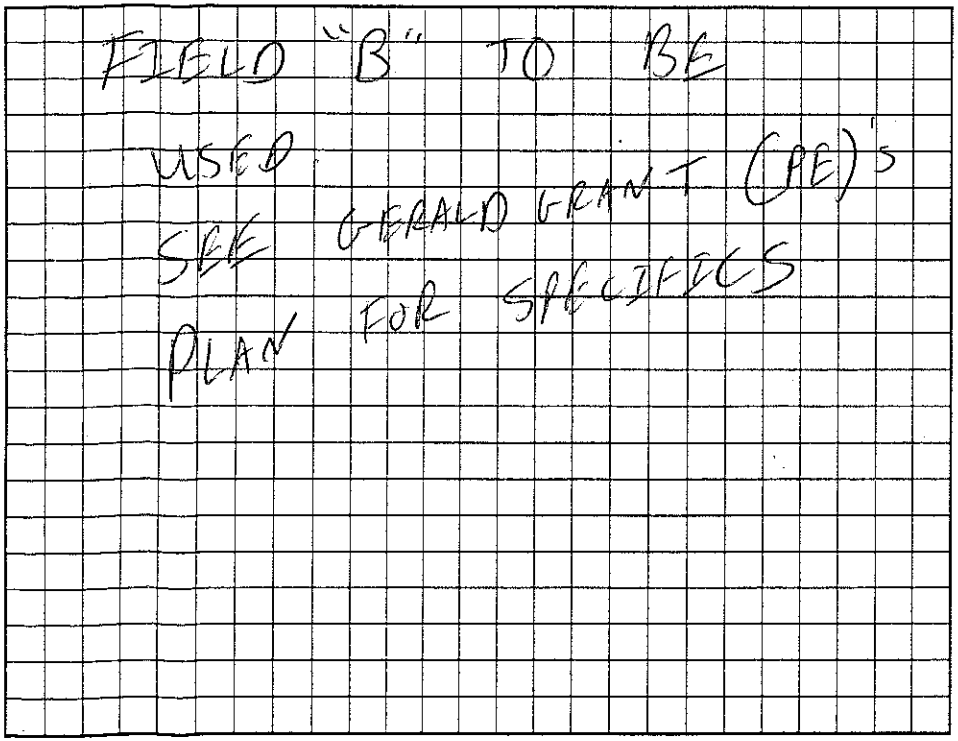

AS BUILT SKETCH

 


Permit can be suspended or revoked if any false information is supplied toward securing the permit/any unauthorized changes are made to the site/any unauthorized changes are made in the installation of the system. Improvement Permit with plat valid without expiration. Improvement Permit with site plan valid for sixty months. Authorization to Construct is valid for a period equal to that of Improvement Permit – not to exceed sixty months.

Signed: Gerald Grant date 8/31/04 Installed by: STEVE JORDAN

Improvement Permit by: C. Sz date 8/12/04 Operation Permit by: C. Sz date 3/3/05

Authorization to Construct by: C. Sz date 8/12/04 Existing System Inspection by: date

HEALTH DEPT. COPY: WHITE OWNER COPY (FINAL): YELLOW OWNER COPY (INITIAL): PINK

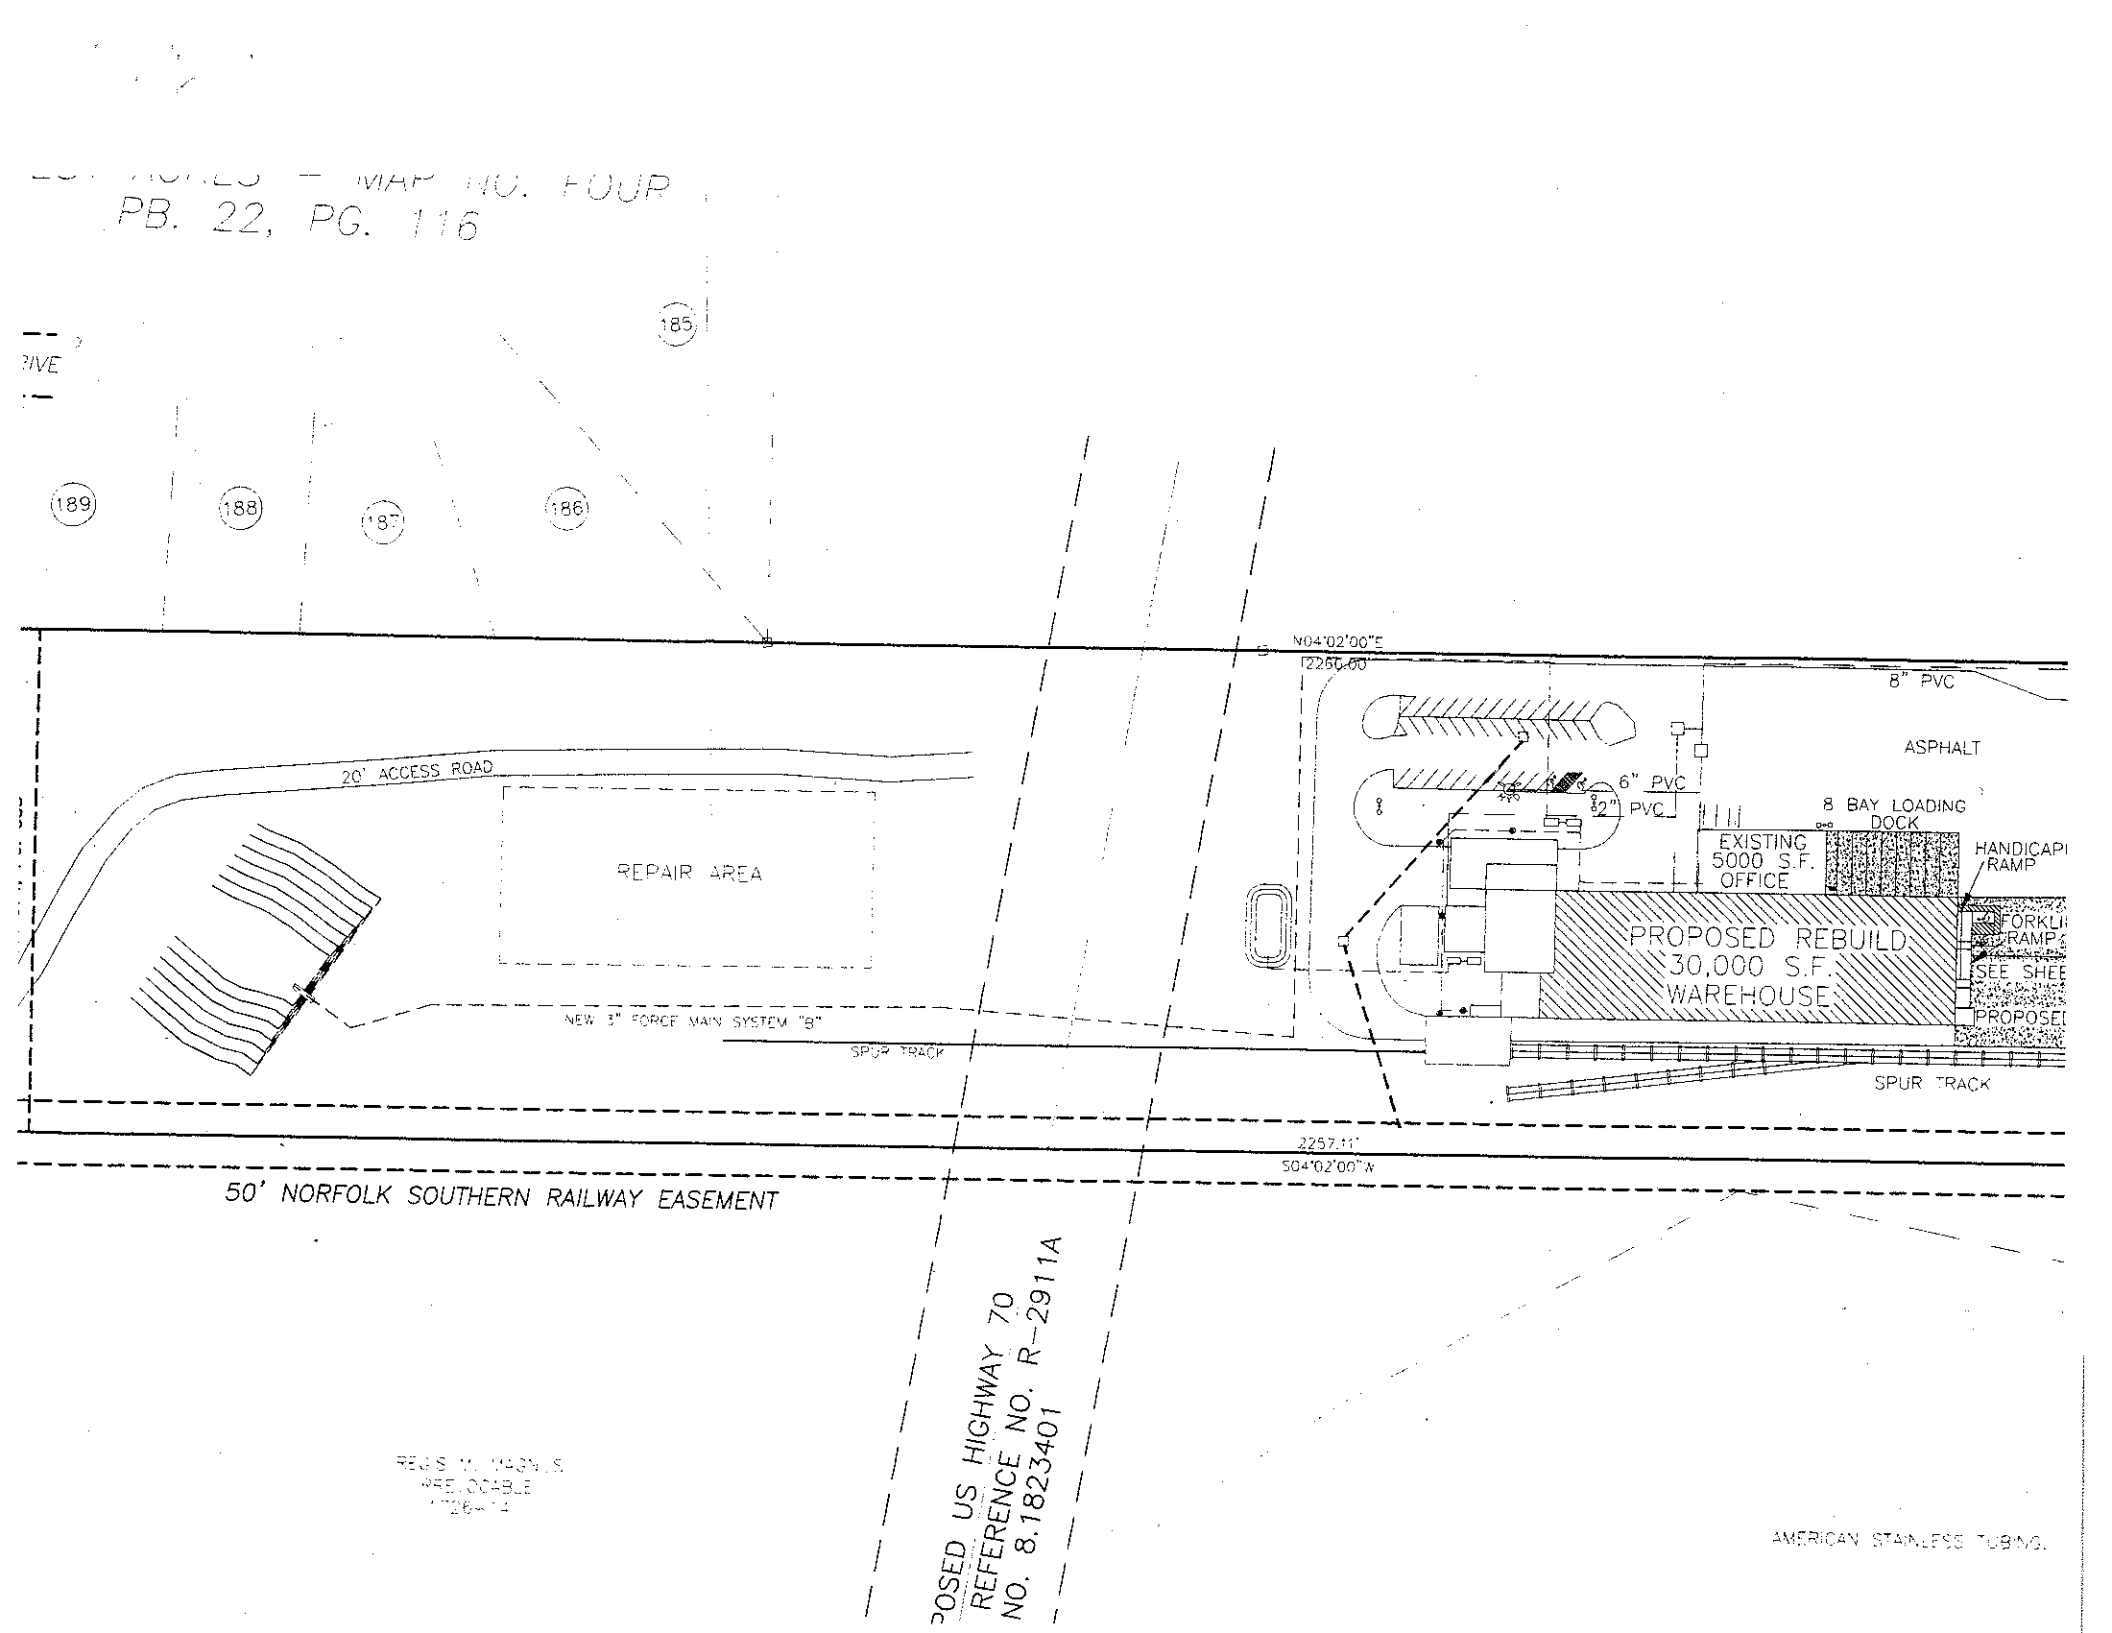
PB. 22, PG. 116
185
189
188
187
186
N04°02'00"E
2250.00'
8" PVC
ASPHALT
20' ACCESS ROAD
REPAIR AREA
6" PVC
2" PVC
8 BAY LOADING DOCK
EXISTING 5000 S.F. OFFICE
HANDICAPI RAMP
PROPOSED REBUILD 30,000 S.F. WAREHOUSE
NEW 3" FORCE MAIN SYSTEM "B"
SPUR TRACK
SPUR TRACK
2257.11'
S04°02'00"W
50' NORFOLK SOUTHERN RAILWAY EASEMENT
PROPOSED US HIGHWAY 70
REFERENCE NO. R-2911A
NO. 8.1823401
AMERICAN STAINLESS TUBING