IREDELL COUNTY HEALTH DEPARTMENT

STATESVILLE 704-878-5305 MOORESVILLE 704-664-5281

IMPROVEMENT PERMIT / CERTIFICATE OF COMPLETION / OPERATION PERMIT / EXISTING SYSTEM INSPECTION

TAX MAP NO. 5K-7-A-230

PROPERTY DESCRIPTION NO. 15535 DATE 8-17-93 PHONE: Business 878-6660 Home

OWNER OR CONTRACTOR T+T Inc.

ADDRESS PO Box 1435 Statesville N.C.

LOCATION 70E TR Marshall TR Well Hse Dr To Big Forest Dr. 1/2mi on Rt

SUBDIVISION Forest Acres BLOCK / SECTION II LOT 230 LOT AREA .49 acres SITE CLASS. PS L.T.A.R. .34

Water Supply: ☐ Individual ☐ Community ☑ Public

Septic Tank: 1000 Gallons: STB 358 Date 6-29-93

Pump Tank: Gallons; PT Date

Nitrification Field: No Fields 1 Square Feet 720 Linear Feet 240

No Lines 3 Trench Width 36 Trench Depth 24+36 Gravel Depth 12

☑ New System ☐ Repair System Type: I, II, III, IV, V, VI

System Description: Conv Gravity

Repair System Description:

Maintenance Agreement Required: ☐ Yes ☑ No

☐ House/Mod. Home No. Bedrooms 2

☐ Mobile Home No. Bathrooms 2

☐ Business No. Employees

☐ Other

Garbage Disposal: ☐ Yes ☑ No

Auto. Dishwasher: ☐ Yes ☑ No


Auto. Washing Machine: ☑ Yes ☐ No

Other


☐ Slab ☑ Crawl Space ☐ Basement w/plumbing ☐ Basement wo/plumbing

Comments

INITIAL SITE SKETCH

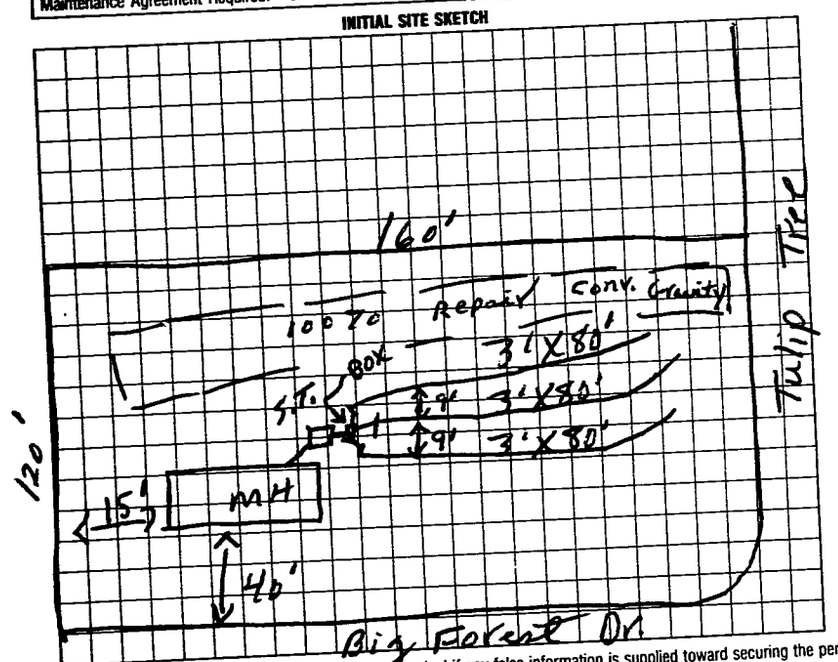

AS BUILT SKETCH

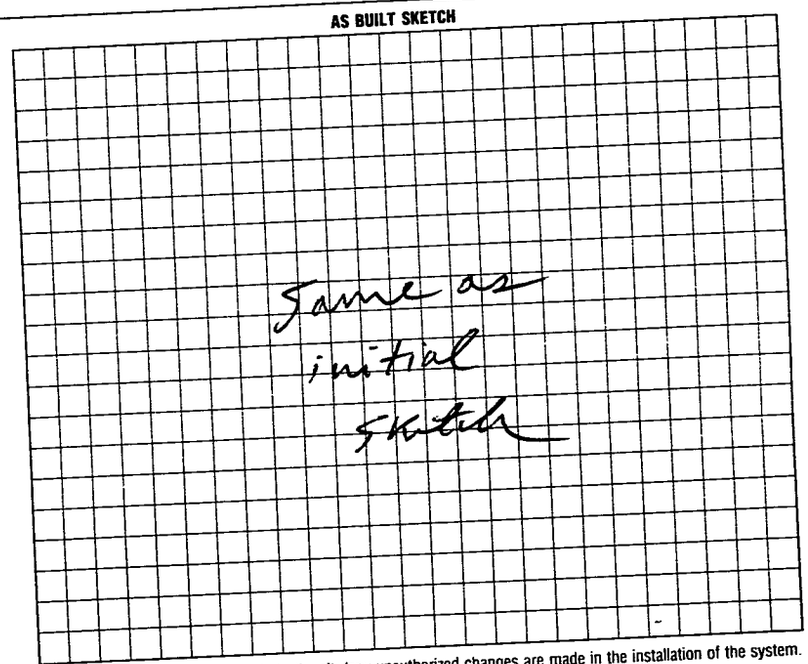

I understand that this permit can be suspended or revoked if any false information is supplied toward securing the permit/any unauthorized changes are made to the site/any unauthorized changes are made in the installation of the system. Improvement Permit is valid for 60 months from date of issuance.

Signed: T+T Co by D. Thabet Installed by: Donald Tucker

Improvement Permit by: L. C. moore date 8-17-93 Certificate of Completion by: L. C. moore date 9-2-93

Existing System Inspection by: Operation Permit by: date

HEALTH DEPT. COPY: WHITE INSPECTION COPY (FINAL): GREEN OWNER COPY (FINAL): YELLOW INSPECTION COPY (INITIAL): PINK OWNER COPY (INITIAL): GOLD