IREDELL COUNTY HEALTH DEPARTMENT

STATESVILLE 704-878-5305 MOORESVILLE 704-664-5281

IMPROVEMENT PERMIT / CERTIFICATE OF COMPLETION / OPERATION PERMIT / EXISTING SYSTEM INSPECTION

PROPERTY DESCRIPTION NO. 18078 DATE 3-21-94 TAX MAP NO. 5K-7-A-224 Watershed: ☐ Yes ☑ No

OWNER OR CONTRACTOR T+T Inc PHONE: Business 878 6660 Home

ADDRESS PO Box 1835 Statesville

LOCATION 702 TR Morehead TR Oltwell Dr TL Big Trout at end on left

SUBDIVISION Forest acres BLOCK / SECTION ✓ LOT 224 LOT AREA .47 acres SITE CLASS. SPS DESIGN FLOW 360 L.T.A.R. 135

Septic Tank: 1000 Gallons; STB 1012 Date 3-15-94

Pump Tank: Gallons; PT Date

Pump Make: Model Serial No.

Nitrification Field: No Fields Square Feet Linear Feet

No Lines 5 Trench Width 36" Max Trench Bottom Depth 36" Gravel Depth 12"

☑ New System ☐ Repair System Type: I, II, III, IV, V, VI

System Description: Conv. Gravity

Repair System Description: Gravity pressure panel

Maintenance Agreement Required: ☐ Yes ☐ No

☐ House/Mod. Home No. Bedrooms 3

☐ Mobile Home No. Bathrooms 2

☐ Business No. Employees

☐ Other


☐ Slab ☑ Crawl Space ☐ Basement w/plumbing ☐ Basement wo/plumbing

Water Supply: ☐ Individual ☑ Community ☑ Public

Comments:

Comments:

INITIAL SITE SKETCH

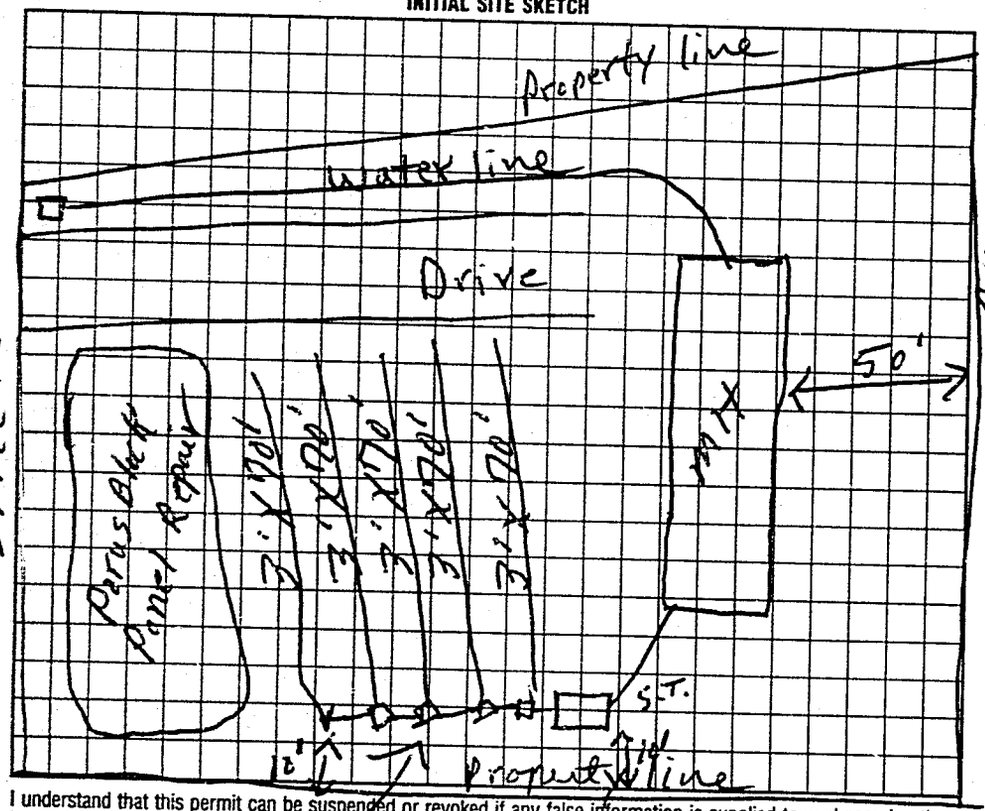

AS BUILT SKETCH

Same as initial sketch

I understand that this permit can be suspended or revoked if any false information is supplied toward securing the permit/any unauthorized changes are made to the site/any unauthorized changes are made in the installation of the system.

Improvement Permit is valid for 60 months from date of issuance.

Signed: X H.J. Thaler DOT boxes

Improvement Permit by: J.C. Moore date 3-21-94

Existing System Inspection by: date

Installed by: Donald Lackey

Certificate of Completion by: J.C. Moore date 5-25-94

Operation Permit by: date

HEALTH DEPT. COPY: WHITE INSPECTION COPY (FINAL): GREEN OWNER COPY (FINAL): YELLOW INSPECTION COPY (INITIAL): PINK OWNER COPY (INITIAL): GOLD