IREDELL COUNTY HEALTH DEPARTMENT

STATESVILLE 704-878-5305 MOORESVILLE 704-664-5281

IMPROVEMENT PERMIT / CERTIFICATE OF COMPLETION / OPERATION PERMIT / EXISTING SYSTEM INSPECTION

PROPERTY DESCRIPTION NO. 15532 DATE 7-5-94 TAX MAP NO. 5-K-7-A-219 Watershed: ☐ Yes ☑ No

OWNER OR CONTRACTOR T & T Inc. PHONE: Business 878-6660 Home

ADDRESS PO Box 2858 Sta

LOCATION 70E TR morehead TR on oldwell Dr. at ent TR Big Forest Dr. 1/2mi on R

SUBDIVISION Forest Acres BLOCK / SECTION I LOT 219 LOT AREA 1/2 acre SITE CLASS. PS DESIGN FLOW 240 L.T.A.R. .3

Septic Tank: 1000 Gallons; STB 1012 Date 4/11/94

Pump Tank: Gallons; PT Date

Pump Make: Model Serial No.

Nitrification Field: No Fields 1 Square Feet 800 Linear Feet 267

No Lines 4 Trench Width 36" Max Trench Bottom Depth 36" Gravel Depth 12"

☑ New System ☐ Repair System Type: I, II, III, IV, V, VI

System Description: Conv. Gravity

Repair System Description: Forus Block Panel Gravity

Maintenance Agreement Required: ☐ Yes ☐ No

☐ House/Mod. Home ☑ Mobile Home ☐ Business ☐ Other

No. Bedrooms 2 No. Bathrooms 1 No. Employees


☐ Slab ☑ Crawl Space ☐ Basement w/plumbing ☐ Basement w/o plumbing

Water Supply: ☐ Individual ☐ Community ☑ Public

Comments:

100' Property Line

INITIAL SITE SKETCH

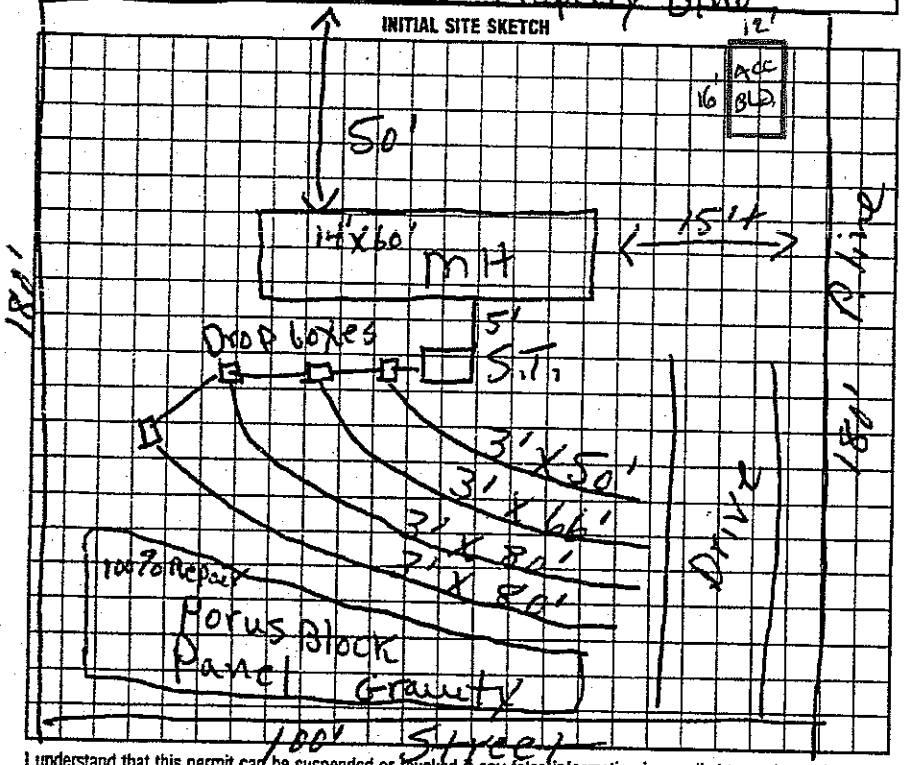

Comments:

AS BUILT SKETCH

SYSTEM INSTALLED ACCORDING TO INITAL SITE SKETCH

Location of the proposed ACCESSORY BUILDING addition does not appear to impact the existing on-site septic system.**NOTE:

R. STEVE HEDRICK REHS

Date: FEBRUARY 22, 2013

ICHD-Environmental Health Division

I understand that this permit can be suspended or revoked if any false information is supplied toward securing the permit/any unauthorized changes are made to the site/any unauthorized changes are made in the installation of the system. Improvement Permit is valid for 60 months from date of issuance.

Signed: X [signature]

Improvement Permit by: P.C. Moore date 7-5-94

Existing System Inspection by: date

Installed by: DONALA LACKEY

Certificate of Completion by: STEVE HEDRICK date 7/14/94

Operation Permit by: date

HEALTH DEPT. COPY: WHITE INSPECTION COPY (FINAL) GREEN OWNER COPY (FINAL) YELLOW INSPECTION COPY (INITIAL): PINK OWNER COPY (INITIAL): GOLD