IREDELL COUNTY HEALTH DEPARTMENT - *ENVIRONMENTAL HEALTH* ☐ STATESVILLE OFFICE ~~704-878-5305~~ ☐ MOORESVILLE OFFICE 704-664-5281

IMPROVEMENT PERMIT / AUTHORIZATION TO CONSTRUCT / OPERATION PERMIT / EXISTING SYSTEM INSPECTION

PERMIT # 16331 PIN # 4763-81-0137 DATE 1 October 10

OWNER Willis L. Mayle APPLICANT: Clayton Hunt PHONE: Home/Cell # (704) 941-5307 Business #

SITE ADDRESS 259 Big Forest Drive Statesville, NC OWNER / APPLICANT ADDRESS

SITE DIRECTIONS Old NC-70 E Turn onto Morehead -TR Old Well House Rd.

SUBDIVISION BLOCK / SECTION LOT # LOT AREA 1/2 Ac. DESIGN FLOW 240 gld L.T.A.R. 0.3 g/ft²/d

Septic Tank Exist. Gallons: STB Date
Pump Tank Gallons: P T Date
Pump Make Model Serial #
No. Nitrification Fields: 1 No. Lines 4 Linear Feet 267
Trench Width 36 Max. Trench Bottom Depth 36 Gravel Depth 12"

☑ New System ☐ Repair ☐ Expansion System Type I (II) III IV V VI
System Description: Conv. Gravity
Repair System Description: 50% Reduction
Maintenance Agreement Required ☐ YES ☑ NO
☑ GRAVITY ☐ PRESSURE

☑ Residence No. Bedrooms 2
☐ Business No. Persons
☐ Other No. Employees
☐ Slab ☐ Crawl Space
☐ Basement w/plumbing ☐ Basement w/o plumbing


Water Supply: ☐ Private ☑ Public ☐ Community

Comments / Conditions

* Keep Home 5' from all portions of existing septic system.

INITIAL SITE SKETCH

AS BUILT SKETCH

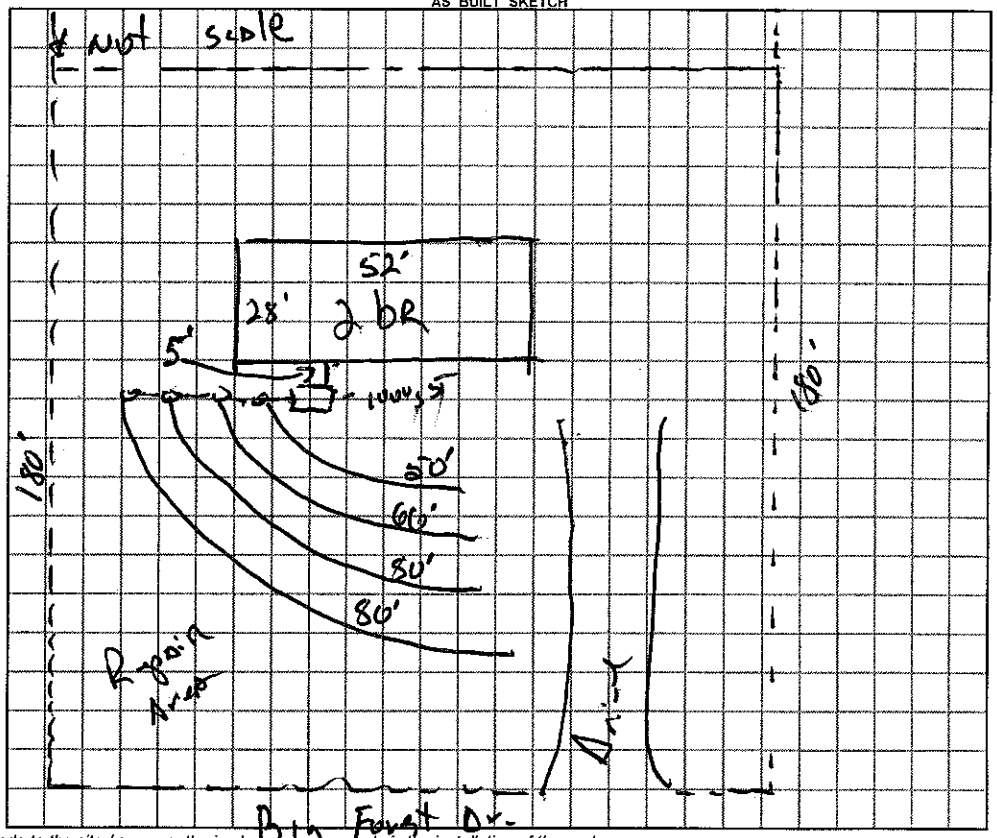

Permit can be suspended or revoked if any false information is supplied toward securing the permit / any unauthorized changes are made to the site / any unauthorized changes are made in the installation of the system.

☐ ***IMPROVEMENT PERMIT*** with plat valid without expiration ☐ ***IMPROVEMENT PERMIT*** with plat valid without expiration. ☐ ***AUTHORIZATION TO CONSTRUCT*** valid for period equal to IMPROVEMENT PERMIT--not to exceed 60 mo.

Owner / Applicant Signature: Date 10-20-10 Installed by:

IMPROVEMENT PERMIT by: REHS Date OPERATION PERMIT by: REHS Date

AUTHORIZATION TO CONSTRUCT by: REHS Date Existing System Inspected by: J. Nuggins, RS. REHS Date 1 Oct. 10

YOU SHOULD CONTACT A LOCATOR SERVICE PRIOR TO ANY EXCAVATION

White Copy – Environmental Health YELLOW COPY (Final) Owner / Applicant PINK COPY (Initial) Owner / Applicant