IREDELL COUNTY HEALTH DEPARTMENT

STATESVILLE 704-878-5305 MOORESVILLE 704-664-5281

IMPROVEMENT PERMIT / CERTIFICATE OF COMPLETION / OPERATION PERMIT / EXISTING SYSTEM INSPECTION

PROPERTY DESCRIPTION NO. 15533 DATE 3-25-94 TAX MAP NO. 5K-7-A-221

OWNER OR CONTRACTOR TFT Co. PHONE: Business 878 labled Home Watershed: ☐ Yes ☒ No

ADDRESS PO Box 258 Sta

LOCATION To S TR Morehead TR Old well Dr. T. Big Forest Dr. Towardsentonleft.

SUBDIVISION Forest acres BLOCK / SECTION V LOT 221 LOT AREA 1/2 acre SITE CLASS. PS DESIGN FLOW 240 L.T.A.R. 135 gallons/day

Septic Tank: 1000 Gallons; STB 1012 Date 3-14-94

Pump Tank: 1000 Gallons; PT PT-12 Date 3-17-94

Pump Make: Goulds Model 3885 Serial No. WE0511H

Nitrification Field: No Fields 1 Square Feet 720 Linear Feet 240

No Lines 2 Trench Width 36" Max Trench Bottom Depth 36" Gravel Depth 12"

☒ New System ☐ Repair System Type: I, II, III, IV, V, VI

System Description: Pump To conv. Lines

Repair System Description: " " " "

Maintenance Agreement Required: ☐ Yes ☒ No

☐ House/Mod. Home ☐ Mobile Home ☐ Business ☐ Other

No. Bedrooms 2 No. Bathrooms 2 No. Employees


☐ Slab ☐ Crawl Space ☐ Basement w/plumbing ☐ Basement wo/plumbing

Water Supply: ☐ Individual ☐ Community ☒ Public


Comments: Use Pump That Will driver 24 gal/min at 25' Total Head

Comments: Wire Pump & Alarm according to Iredell Co Building Insp Dept & standards & State Elec. Code

INITIAL SITE SKETCH

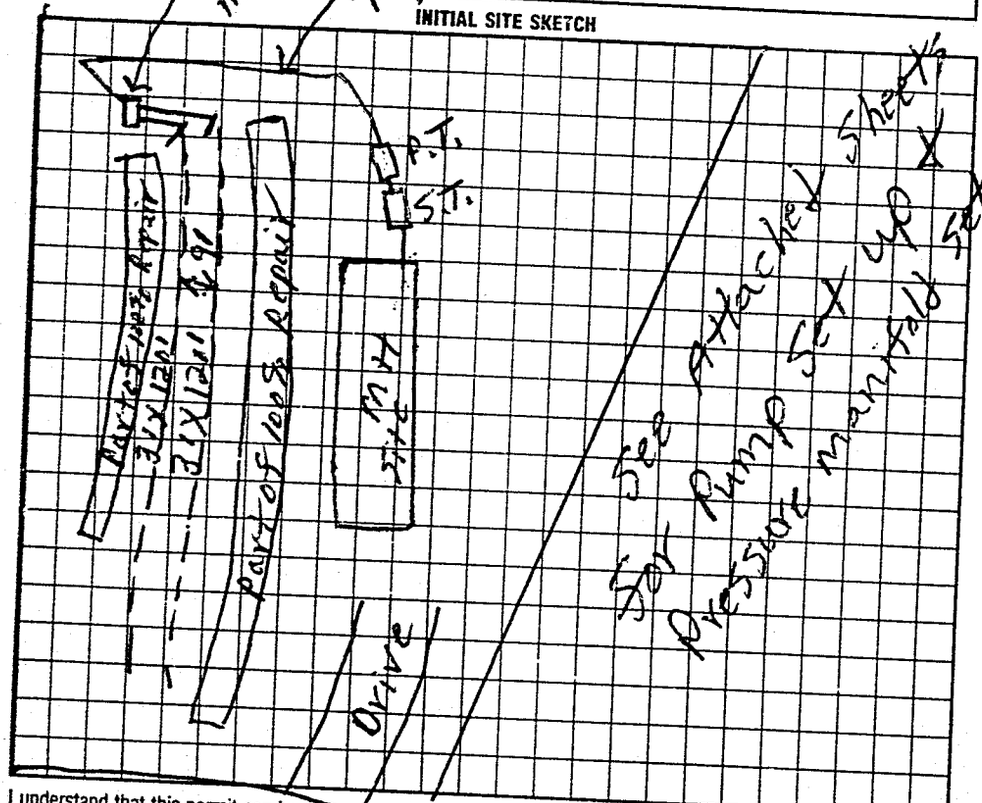

AS BUILT SKETCH

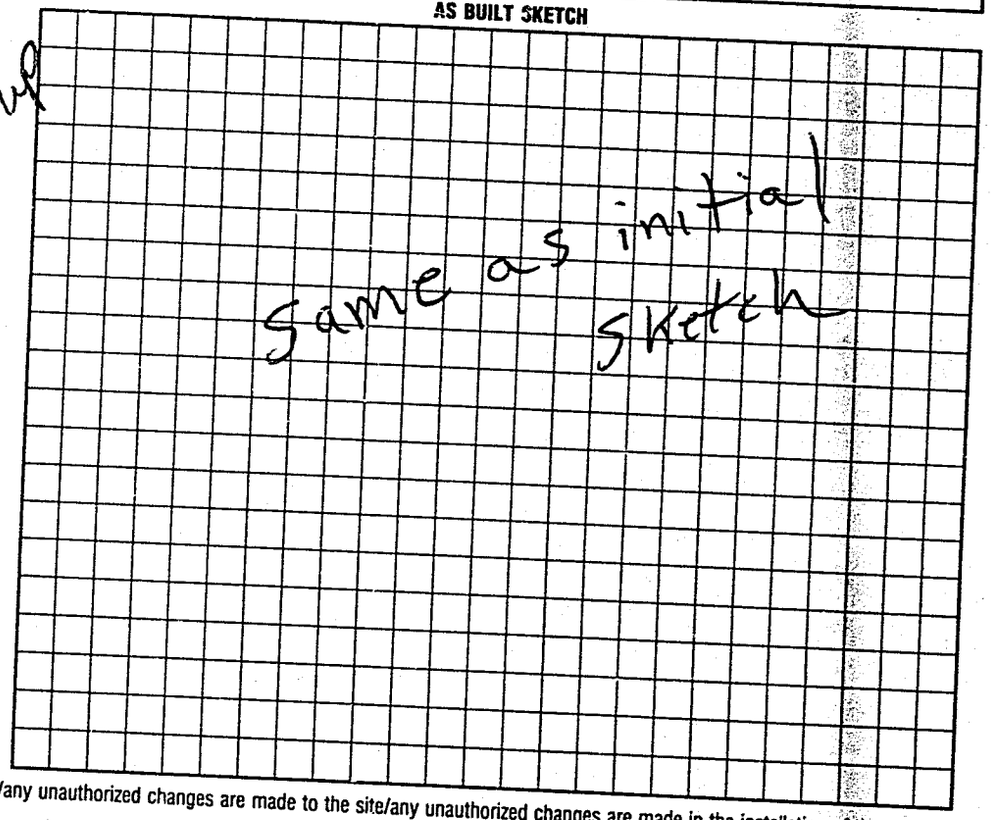

I understand that this permit can be suspended or revoked if any false information is supplied toward securing the permit/any unauthorized changes are made to the site/any unauthorized changes are made in the installation of the system. Improvement Permit is valid for 60 months from date of issuance.

Signed: X [signature]

Improvement Permit by: L. C. Moore date 3-25-94

Existing System Inspection by: _____ date _____

Installed by: _____

Certificate of Completion by: _____ date _____

Operation Permit by: L. C. Moore date 5-27-94

HEALTH DEPT. COPY: WHITE INSPECTION COPY (FINAL): GREEN OWNER COPY (FINAL): YELLOW INSPECTION COPY (INITIAL): PINK OWNER COPY (INITIAL): GOLD