IREDELL COUNTY HEALTH DEPARTMENT

STATESVILLE 704-878-5305 MOORESVILLE 704-664-5281

IMPROVEMENT PERMIT / CERTIFICATE OF COMPLETION / OPERATION PERMIT / EXISTING SYSTEM INSPECTION

PROPERTY DESCRIPTION NO. 18079 DATE 3-23-94 TAX MAP NO. 5K-7-A-222 Watershed: ☐ Yes ☑ No

OWNER OR CONTRACTOR T+T Inc PHONE: Business Home 878-6660

ADDRESS PO Box 288 Sta.

LOCATION 70 E TR Morehead TR Oldwell Dr. TL Big Forest 1/2 mi L

SUBDIVISION Forest Acres BLOCK / SECTION I LOT 222 LOT AREA .86 acres SITE CLASS PS DESIGN FLOW 360 L.T.A.R. .135

Septic Tank: 1000 Gallons; STB Date

Pump Tank: Gallons; PT Date

Pump Make: Model Serial No.

Nitrification Field: No Fields 1 Square Feet 1035 Linear Feet 345

No Lines Trench Width Max Trench Bottom Depth Gravel Depth

☑ New System ☐ Repair System Type: I, II, III, IV, V, VI

System Description: Conv. Gravity

Repair System Description: " "

Maintenance Agreement Required: ☐ Yes ☑ No

☐ House/Mod. Home No. Bedrooms 3

☑ Mobile Home No. Bathrooms 2


☐ Business No. Employees

☐ Other

☐ Slab ☑ Crawl Space ☐ Basement w/plumbing ☐ Basement wo/plumbing

Water Supply: ☐ Individual ☐ Community ☑ Public

Comments:

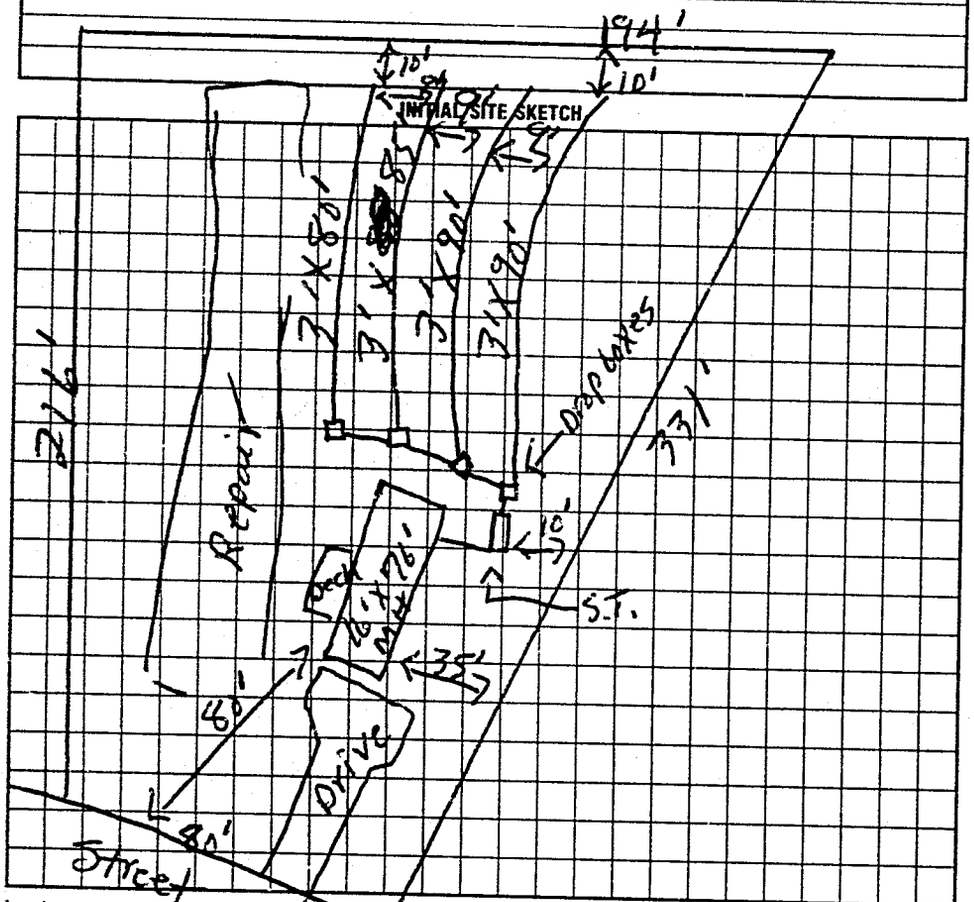

Comments:

AS BUILT SKETCH

Same as initial sketch

I understand that this permit can be suspended or revoked if any false information is supplied toward securing the permit/any unauthorized changes are made to the site/any unauthorized changes are made in the installation of the system. Improvement Permit is valid for 60 months from date of issuance

Signed: T+T Corp by J. Thabet

Improvement Permit by: L.C. Moore date 3-23-94

Existing System Inspection by: date

Installed by: Donald Hackney

Certificate of Completion by: L.C. Moore date 5-25-94

Operation Permit by: date

HEALTH DEPT. COPY: WHITE INSPECTION COPY (FINAL): GREEN OWNER COPY (FINAL): YELLOW INSPECTION COPY (INITIAL): PINK OWNER COPY (INITIAL): GOLD