IREDELL COUNTY HEALTH DEPARTMENT

STATESVILLE 704-878-5305 MOORESVILLE 704-664-5281

IMPROVEMENT PERMIT / CERTIFICATE OF COMPLETION / OPERATION PERMIT / EXISTING SYSTEM INSPECTION

PROPERTY DESCRIPTION NO. 26343 DATE 3-13-97 ~~TAX MAP NO.~~ PIN NO. 4763-84-4753 Watershed: ☐ Yes ☐ No

OWNER OR CONTRACTOR American Stainless PHONE: Business 873-4325 Home

ADDRESS 123 Morehead Rd Statesville

LOCATION Hwy 70 E TR Morehead Rd 800' on left. 1st Building on left on Proper

SUBDIVISION BLOCK / SECTION LOT LOT AREA 13 acres SITE CLASS. PJ DESIGN FLOW 1250 L.T.A.R. .133 gal/sq ft/d

Septic Tank: 2000 Gallons; STB 633 Date 4-15-97

Pump Tank: 2500 Gallons; PT 96 Date 6-13-94

Pump Make: Gould's Model WE07T2H Serial No. 1pwE0h72H

Nitrification Field: No Fields 1 Square Feet 1260 Linear Feet 630

No Lines 6 Trench Width 24" Max Trench Bottom Depth 36" Gravel Depth N/A

☑ New System ☐ Repair System Type: I, II, III, IV, V, VI

System Description: Pressure Dosed Panels

Repair System Description:

Maintenance Agreement Required: ☑ Yes ☐ No

☐ House/Mod. Home No. Bedrooms

☐ Mobile Home No. Bathrooms

☑ Business No. Employees 50

☐ Other


☑ Slab ☐ Crawl Space ☐ Basement w/plumbing ☐ Basement wo/plumbing

Water Supply: ☐ Individual ☐ Community ☑ Public


Comments: (1) System for Domestic waste only
(2) See attached sheets for Pump Tank & Pressure line set up which are part of This permit.
(3) A certified operater will have to be on contract before operations permit can be issued.

Comments: Inspected Drain Lines & Tank & Pressure Tested Pump 6-12-97 Jem

INITIAL SITE SKETCH

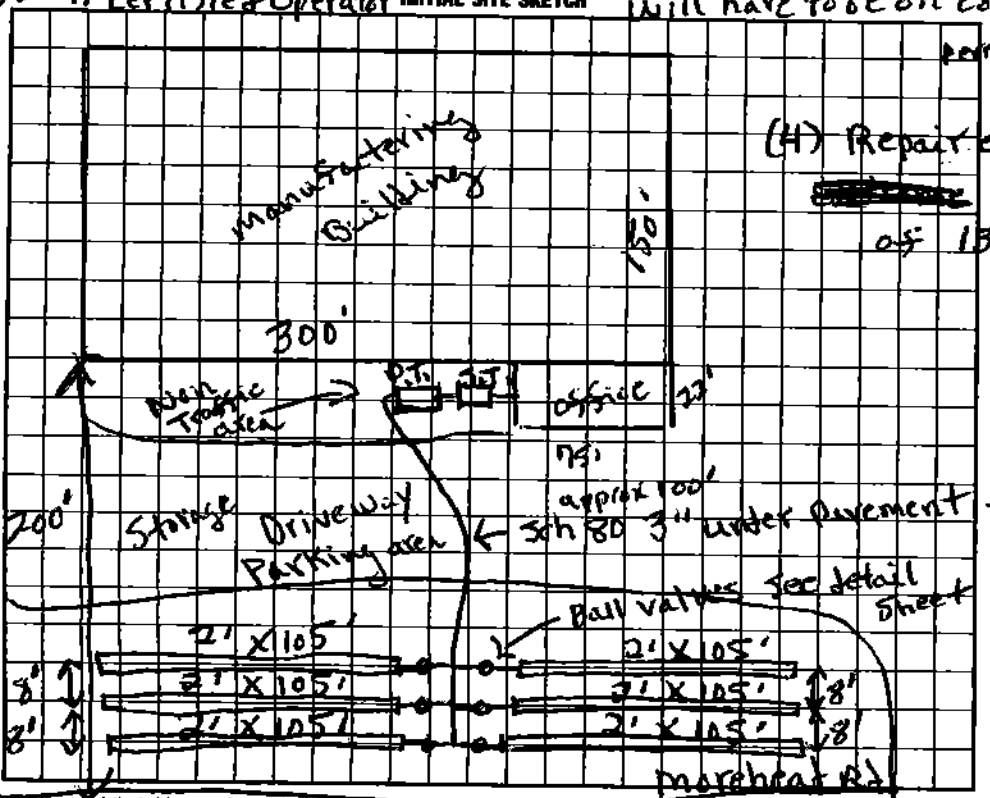

AS BUILT SKETCH

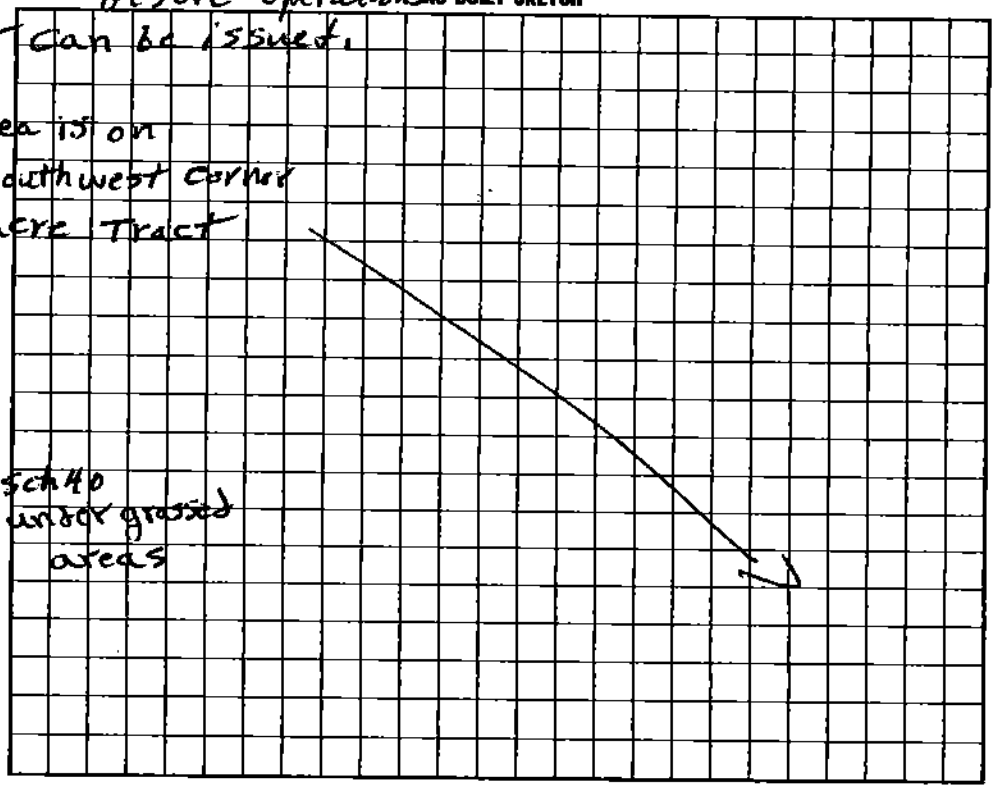

I understand that this permit can be suspended or revoked if any false information is supplied toward securing the permit/any unauthorized changes are made to the site/any unauthorized changes are made in the installation of the system. Improvement Permit is valid for 60 months from date of issuance.

Signed: William Bird

Improvement Permit by: P. C. Moore date 3-13-97

Authorization to Construct by: P. C. Moore date 3-13-97

Installed by: Donald Lackey

Certificate of Completion by: date

Operation Permit by: P. C. Moore date 1-29-98

HEALTH DEPT. COPY: WHITE INSPECTION COPY (FINAL): GREEN OWNER COPY (FINAL): YELLOW INSPECTION COPY (INITIAL): PINK OWNER COPY (INITIAL): GOLD