IREDELL COUNTY HEALTH DEPARTMENT

Statesville Phone TR 3-7271 Mooresville Phone NO 3-1271

PERMIT TO INSTALL SEPTIC TANK

Permit NO. 308 Permit Date Sept. 7 1970

Owner Dick Raymer Address Statesville, NC

Installed By Adams Septic Tank Service Address Taylorsville, NC


Location of Property Statesville Country Club - Augusta Drive -

Tank		Capacity		Length of Lines		Fixtures	
Block	( )	1000	( )	225'	( )	No. of Baths	(5)
Precast	(✓)	1250	(✓)	250'	( )	Dishwasher	(1)
		1500	( )	Other 260		Garbage Grdr.	(1)
		Other		900 sq ft. N.A. Area		Other	

NOTIFY HEALTH DEPARTMENT AT LEAST EIGHT HOURS BEFORE TANK IS TO BE INSPECTED.

Final Inspection Sept. 9 1970 Approved (✓) Disapproved ( )

Remarks Extra Toilet Line added to field.

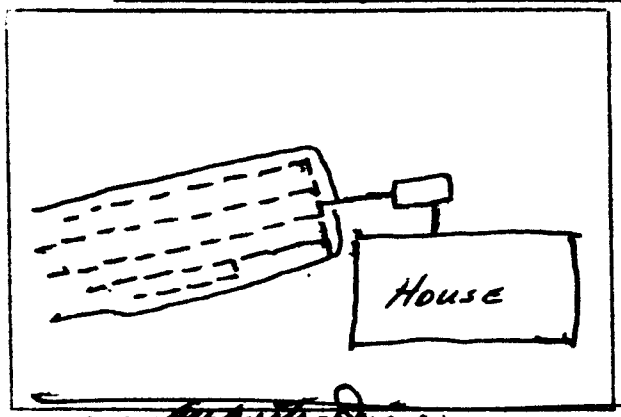

Sketch of Installation

Sanitarian