IREDELL COUNTY HEALTH DEPARTMENT

Statesville Phone TR 3-7271 Mooresville Phone NO 3-1271

PERMIT TO INSTALL SEPTIC TANK

Permit NO. Gene Troutman Permit Date June 25 1965

Owner Little Builder Address Shannon Acres.

Installed By C Hoke Address R7


Location of Property 2nd entrance in to Shannon Acres Corner lot 2nd street to R. 2 story brick before golf course

Tank		Capacity		Length of Lines		Fixtures	
Block	( )	1000	( )	225'	( )	No. of Baths	(3)
Precast	(✓)	1250	(✓)	250'	( )	Dishwasher	(—)
		1500	( )	Other 270'		Garbage Grdr.	(—)
		Other				Other	

NOTIFY HEALTH DEPARTMENT AT LEAST EIGHT HOURS BEFORE TANK IS TO BE INSPECTED.

Final Inspection 19 Approved ( ) Disapproved ( )

Remarks well 100' - wooded

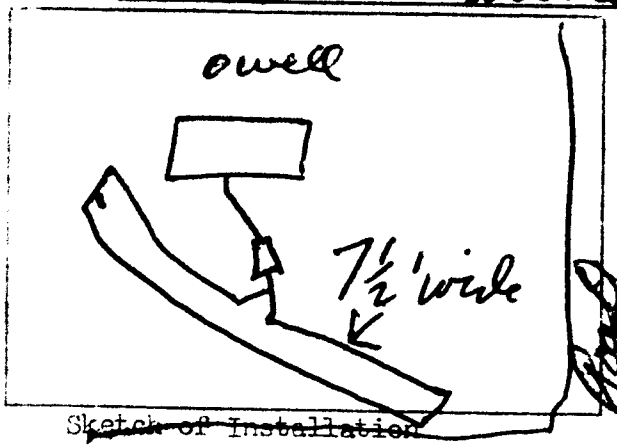

Sketch of Installation

Sanitarian