IREDELL COUNTY HEALTH DEPARTMENT

Statesville Phone TR 3-7271 — Mooresville Phone NO 3-1271

PERMIT TO INSTALL SEPTIC TANK

Permit NO. _____ Permit Date 8-24-1961

Owner Jack Bryant. Address County Club Est.

Installed By C Hobbs Address R7 -


Location of Property ~~Hwy~~ 2nd entrance to County Club. on E. Rd. Left about 2 block on R.

Tank		Capacity		Length of Lines		Fixtures	
Block	( )	800	( )	150'	( )	No. of Baths	(2)
Precast	(✓)	900	( )	175'	( )	Dishwasher	( )
		1000	( )	200'	( )	Garbage Grdr.	( )
Lash		1100	( )	225'	( )	Auto-Washer	(—)
		1200	( )	250'	(✓)	Other	
		Other 1250		Other			

NOTIFY HEALTH DEPARTMENT AT LEAST EIGHT HOURS BEFORE TANK IS TO BE INSPECTED.

Final Inspection 8-24 1961 Approved (✓) Disapproved ( )

Remarks Very heavily wooded - will 5' ditch,

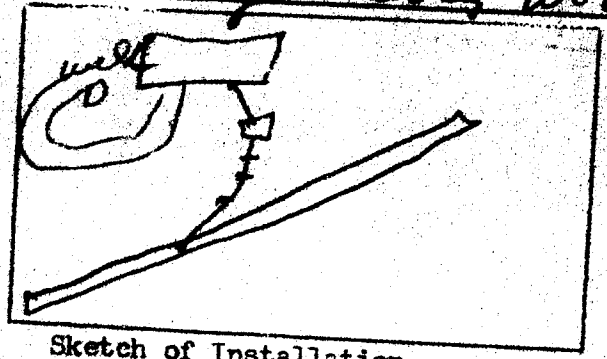

Sketch of Installation

Sanitarian