IREDELL COUNTY HEALTH DEPARTMENT

Statesville Phone TR 3-7271 Mooresville Phone NO 3-1271

PERMIT TO INSTALL SEPTIC TANK

Permit NO. H & A Builders Permit Date May 26 1965

Owner Brisk Address Shannon Acres

Installed By C Hoke Address R 1


Location of Property 2 nd Street into New County Club - Split level on left. beige brick.

Tank	Capacity	Length of Lines	Fixtures
Block ( )	800 ( )	150' ( )	No. of Baths (3)
Precast (✓)	900 ( )	175' ( )	Dishwasher (✓)
	1000 ( )	200' ( )	Garbage Grdr. (✓)
	1100 ( )	225' ( )	Auto-Washer (✓)
	1200 ( )	250' ( )	Other
	Other 1250	Other 295 ft	

NOTIFY HEALTH DEPARTMENT AT LEAST EIGHT HOURS BEFORE TANK IS TO BE INSPECTED.

Final Inspection _____ 19___ Approved ( ) Disapproved ( )

Remarks well 60'

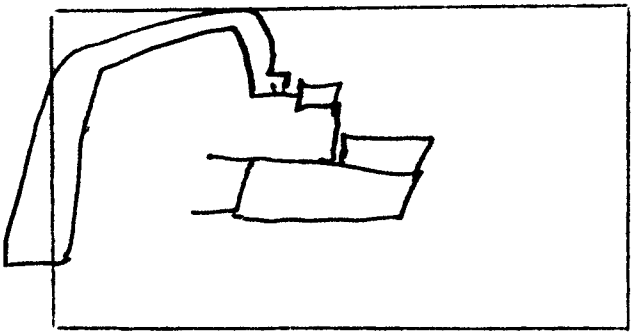

Sketch of Installation

Road

Sanitarian