IREDELL COUNTY HEALTH DEPARTMENT

Statesville Phone TR 3-7271 Mooresville Phone No. 664-5281

PERMIT TO INSTALL SEPTIC TANK

Permit No. _____ Permit Date 8-9 1973

Owner FRED LOWERY Address 425 St ANDREWS Rd.

Installed By SAM OSTWALT Address Troutman, NC.


Location of Property 425 St Andrews Rd -
STATESVILLE Country Club

Tank	Capacity		Length of Lines		Fixtures	
Block	1000	( )	225'	( )	No. of Baths	( )
Precast	REPAIR	( )	250'	( )	Dishwasher	( )
	1500	( )	Other 168		Garbage Grdr.	( )
	Other _____				Other _____	

NOTIFY HEALTH DEPARTMENT AT LEAST EIGHT HOURS BEFORE TANK IS TO BE INSPECTED.

Final Inspection 8-9 1973 Approved (✓) Disapprcved ( )

Remarks _____

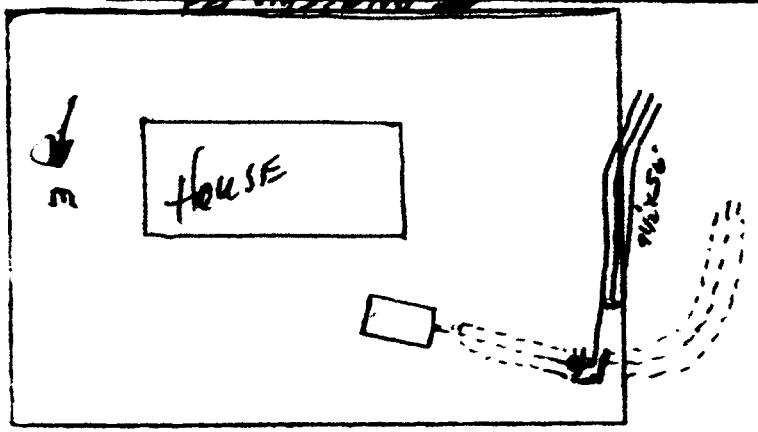

Sketch of Installation

DUE TO LACK OF SPACE
6" of Additional Stone
Added to Nitrification
Field.

Glenn T. D.
Sanitarian