Statesville Phone TR 3-7271

IREDELL COUNTY HEALTH DEPARTMENT

Mooresville Phone No. 664-5281

Permit No. _____

PERMIT TO INSTALL SEPTIC TANK

Permit Date 26 July 1973

Owner Nelson Gordon Address County Club Statesville

Installed By Raymond Adams Address Hickory, N. C.


Location of Property Statesville County Club off East Broad St. on St. Andrews.

Tank		Capacity		Length of Lines		Fixtures	
Block	( )	1000	( )	225'	( )	No. of Baths	(2)
Precast	(✓)	1250	(✓)	250'	( )	Dishwasher	( )
		1500	( )	Other 276'		Garbage Grdr.	(✓)
		Other				Other	

NOTIFY HEALTH DEPARTMENT AT LEAST EIGHT HOURS BEFORE TANK IS TO BE INSPECTED.

Final Inspection 26 July 1973 Approved (✓) Disapproved ( )

Remarks

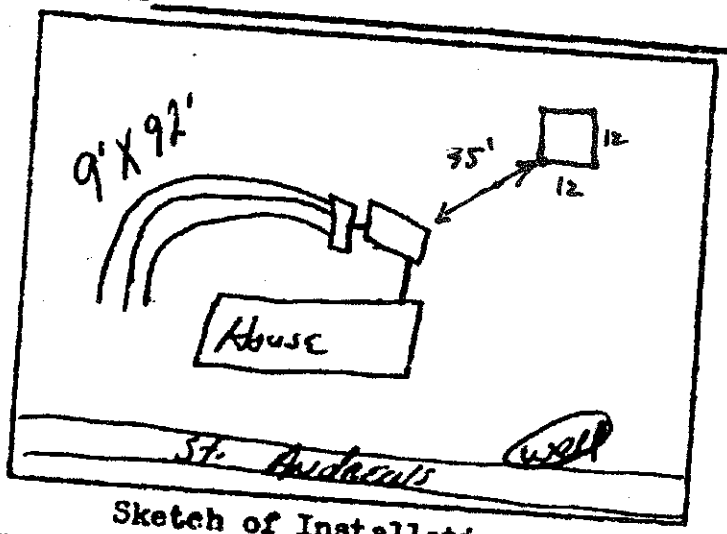

Sketch of Installation

928 sq ft. Not enough room for 900 sq. ft. Job. Some amt. of stone used for 900 sq ft job. Insulation test run - 58 penalty

The location of the proposed hot tub addition does not appear to impact the existing septic system.

**NOTE: _____

REHS

Date: 10-4-10

ICHD-Environmental Health Division

William M. Howard

Sanitarian