IREDELL COUNTY HEALTH DEPARTMENT

Statesville Phone TR 3-7271 Mooresville Phone NO 3-1271

PERMIT TO INSTALL SEPTIC TANK

Permit No. C B Gant Bldr. Permit Date Nov 16 1966

Owner Dr. M. L. Dalton (Dentist) Address Statesville

Installed By C Hoke Address R 7


Location of Property Shannon Acres - 2nd Rd to R off E. Bud St. 3 blks. left. 1 Blk. left. on corner. 3 story house

Tank		Capacity		Length of Lines		Fixtures	
Block	( )	1000	( )	225'	( )	No. of Baths	(4
Precast	(✓)	1250	(✓)	250'	( )	Dishwasher	(✓)
		1500	( )	Other 285 ft. 712.5 sq ft.		Garbage Grdr.	(✓)
		Other				Other	

NOTIFY HEALTH DEPARTMENT AT LEAST EIGHT HOURS BEFORE TANK IS TO BE INSPECTED.

Final Inspection 19 Approved ( ) Disapproved ( )

Remarks well 150' Not liable for any damage due to grading or concrete trucks.

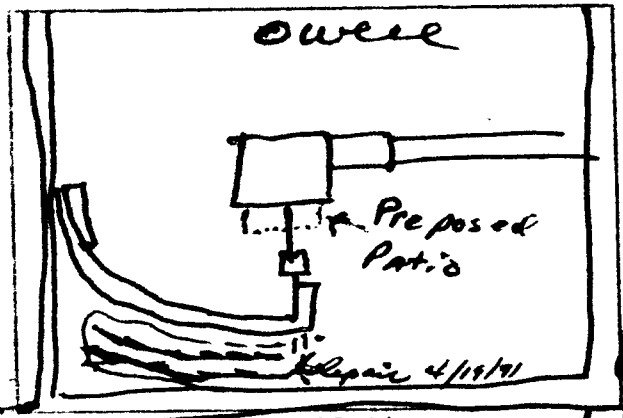

Sketch of Installation

Sanitarian