IREDELL COUNTY HEALTH DEPARTMENT

Statesville Phone TR 3-7271 Mooresville Phone No. 664-5281

PERMIT TO INSTALL SEPTIC TANK

Permit No. 11 Permit Date 6-8 1973

Owner Dr. LEWIS Address 54 Cloud Dr. STATESVILLE

Installed By Raymond ADAMS Address Iiddnite, N.C.


Location of Property 54 Cloud Dr. Country Club

Tank	Capacity		Length of Lines		Fixtures	
Block	1000	( )	225'	( )	No. of Baths	( )
Precast REPAIR	1250	( )	250'	( )	Dishwasher	( )
	1500	( )	Other 300 900 sq ft		Garbage Grdr.	( )
	Other				Other	

NOTIFY HEALTH DEPARTMENT AT LEAST EIGHT HOURS BEFORE TANK IS TO BE INSPECTED.

Final Inspection 6-8 1973 Approved (✓) Disapproved ( )

Remarks

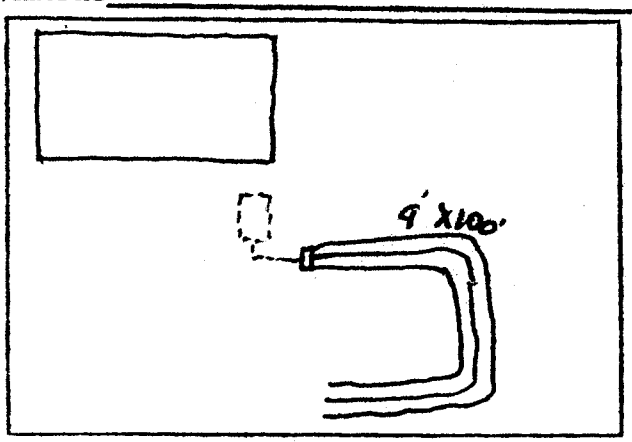

Sketch of Installation

54 Cloud Dr.

Sanitarian