IREDELL COUNTY HEALTH DEPARTMENT

Statesville Phone TR 3-7271 Mooresville Phone NO 3-1271

PERMIT TO INSTALL SEPTIC TANK

Permit No. 143 Permit Date 3-14 1972

Owner Ray Warren (Dr Lewis) Address Statesville NC.

Installed By Raymond Adams Address Huddenite NC


Location of Property out East Broad St Ext to St Andrews Rd TR goto End of Street T.R. then T.R. on St Cloud. House at end of Street on L.

Tank		Capacity		Length of Lines		Fixtures	
Block	( )	1000	(✓)	225'	( )	No. of Baths	(2)
Precast	(✓)	1250	( )	250'	( )	Dishwasher	(✓)
		1500	( )	Other 240		Garbage Grdr.	( )
		Other				Other	

NOTIFY HEALTH DEPARTMENT AT LEAST EIGHT HOURS BEFORE TANK IS TO BE INSPECTED.

Final Inspection 3-14 1972 Approved (✓) Disapproved ( )

Remarks

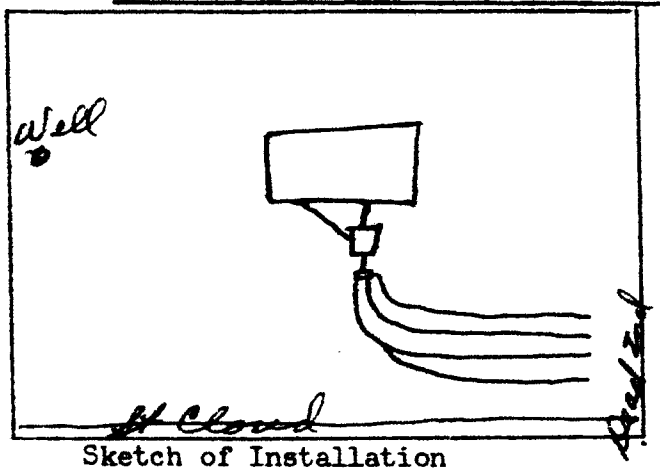

Sketch of Installation

E. A. Stevenson

Sanitarian